

MISSISSIPPI DEPARTMENT OF NATURAL RESOURCES

Bureau of Land and Water Resources

Southport Mall

P.O. Box 10631

Jackson, Mississippi 39209

WATER WELL DRILLERS LOG


PIKE
Coosho

1-13 1986  
date well completed

Fitzgerald Well Sew  
firm name

Pike  
county well located

LANDOWNER:	description of formations encountered	from	to
Mary Mannings RR 2, Ruth, ms. (mailing address)			
WELL LOCATION:			
sec. <u>3</u> T <u>4</u> N R <u>9</u> E S W			
<u>4</u> miles <u>N</u> of <u>Pineblow</u> (distance) (direction) (nearest town)			
WELL PURPOSE: <u>Home</u> (home, irrigation, municipal, industrial)			
WELL COMPLETION DATA:			
(1) diameter (inches) <u>4</u>			
(2) total depth (feet) <u>100</u>			
(3) static water level (feet) <u>55</u> below top of ground. above			
(4) casing <u>PVC</u> , <u>90</u> (material) (depth) <u>4</u> if telescope see back. (size)			
(5) screen <u>10</u> , <u>90</u> (length) (depth to top) <u>4</u> , <u>PVC</u> (size) (material)			
(6) pump <u>1/2</u> , <u>10</u> (HP) (yield gpm) <u>Electric</u> (type power)			
(7) electric log <u>no</u> (yes or no) <u> </u> (organization running log)			
(8) how well bottom plugged <u>hard pack</u>			

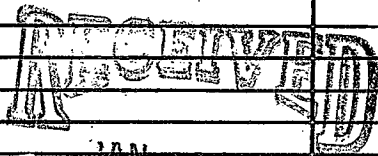


JAN 30 1986

DRILLERS REMARKS:

Department of Natural Resources  
Bureau of Land & Water Resources

If well telescopes please sketch and show depths.

GROUND LEVEL

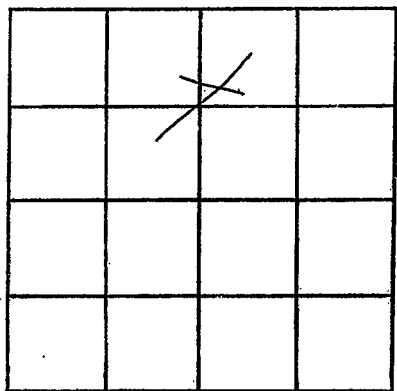

SECTION 3

Please indicate well location X.

ADDITIONAL INFORMATION

If more than one screen,  
show locations of each on sketch.