

MISSISSIPPI DEPARTMENT OF NATURAL RESOURCES

Bureau of Land and Water Resources

Southport Mall

P.O. Box 10631

Jackson, Mississippi 39209

WATER WELL DRILLERS LOG


PIKE
C 2088

3-10
date well completed

1986 Fitzgerald Well Ser
firm name

Pike
county well located


LANDOWNER:	description of formations encountered	from	to
Buddy Fitchell	Red clay	0	20
R.R. Summit, M.S. (mailing address)	Red sand	20	80
	Coarse sand & gravel	80	95
WELL LOCATION:			
sec. <u>8</u> T <u>4</u> N R <u>9</u> E S W <u>1/2</u> miles <u>N</u> of <u>Felders</u> (distance) (direction) (nearest town)			
WELL PURPOSE: <u>Home</u> (home, irrigation, municipal, industrial)			
WELL COMPLETION DATA:			
(1) diameter (inches) <u>4</u>			
(2) total depth (feet) <u>95</u>			
(3) static water level (feet) <u>35</u> below above top of ground.			
(4) casing <u>PVC</u> , <u>85</u> , (material) (depth) <u>4</u> (size) if telescope see back.			
(5) screen <u>10</u> , <u>85</u> (length) (depth to top)			
(6) pump <u>4</u> , <u>PVC</u> (size) (material)			
(7) pump <u>1/2</u> , <u>10</u> (HP) (yield gpm)			
(8) <u>Electric</u> (type power)			
(9) electric log <u>No</u> (yes or no)			
(10) <u>Land LLC</u> (organization running log)			
(11) how well bottom plugged			
DRILLERS REMARKS:			

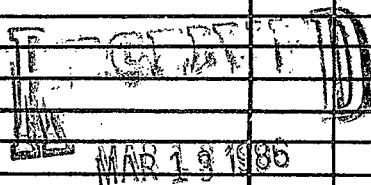

Department of Natural Resources
Bureau of Land & Water Resources

If well telescopes please sketch and show depths.

GROUND LEVEL

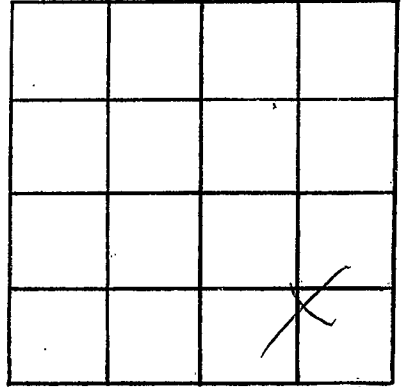

SECTION 8

Please indicate well location X.

ADDITIONAL INFORMATION

A series of horizontal lines for recording additional information.

If more than one screen, show locations of each on sketch.