

PIKE  
C 2089

MISSISSIPPI DEPARTMENT OF NATURAL RESOURCES  
 Bureau of Land and Water Resources  
 Southport Mall  
 P.O. Box 10631  
 Jackson, Mississippi 39209  
**WATER WELL DRILLERS LOG**

7-29 1986 Fitzgerald Well Serv Pike  
 date well completed firm name county well located

LANDOWNER:	description of formations encountered	from	to
<u>Martin Hayden</u> <u>B.R. 1, Dossess ms.</u> (mailing address)	<u>Red clay</u> <u>Red Sand</u> <u>Coarse sand &amp; gravel</u>	<u>0</u> <u>20</u> <u>120</u>	<u>20</u> <u>120</u> <u>135</u>
<b>WELL LOCATION:</b>			
sec. <u>11</u> T <u>4</u> N R <u>9</u> E S W			
<u>4</u> miles <u>N</u> of <u>Pinebluff</u> (distance) (direction) (nearest town)			
<b>WELL PURPOSE:</b> <u>Home</u> (home, irrigation, municipal, industrial)			
<b>WELL COMPLETION DATA:</b>			
(1) diameter (inches) <u>4</u>			
(2) total depth (feet) <u>135</u>			
(3) static water level (feet) <u>90</u> <u>below</u> above top of ground.			
(4) casing <u>PVC</u> , <u>125</u> , (material) (depth) <u>4</u> (size) If telescope see back.			
(5) screen <u>10</u> , <u>125</u> (length) (depth to top) <u>4</u> , <u>PVC</u> (size) (material)			
(6) pump <u>1/2</u> <u>10</u> (HP) (yield gpm) <u>elec</u> (type power)			
(7) electric log <u>no</u> (yes or no) <u>(organization running log)</u>			
(8) how well bottom plugged <u>Lead Shank</u>			
<b>DRILLERS REMARKS:</b>			


**RECEIVED**

**AUG 13 1986**

Department of Natural Resources  
 Bureau of Land & Water Resources

If well telescopes please sketch and show depths.

GROUND LEVEL

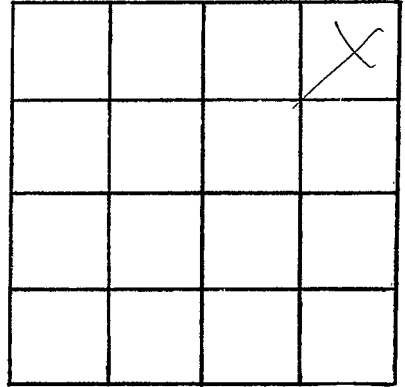

SECTION 11

Please indicate well location X.

ADDITIONAL INFORMATION

If more than one screen,  
show locations of each on sketch.