

PIKE
C 2090

MISSISSIPPI DEPARTMENT OF NATURAL RESOURCES
Bureau of Land and Water Resources
Southport Mall
P.O. Box 10631
Jackson, Mississippi 39209
WATER WELL DRILLERS LOG

7-22 1986 Edwards Well Serv Pike
date well completed firm name county well located

LANDOWNER:	description of formations encountered	from	to
<u>Roy Jenkins</u> <u>RR. Ruth, Mrs.</u> (mailing address)	<u>Red clay</u> <u>Red sand</u> <u>Coarse sand & gravel</u>	<u>0</u> <u>20</u> <u>98</u>	<u>20</u> <u>98</u> <u>111</u>
WELL LOCATION:			
sec. <u>5</u> T <u>4</u> N R <u>9</u> E S W			
<u>2</u> miles <u>N</u> of <u>Felton</u> (distance) (direction) (nearest town)			
WELL PURPOSE: <u>Home</u> (home, irrigation, municipal, industrial)			
WELL COMPLETION DATA:			
(1) diameter (inches) <u>4</u>			
(2) total depth (feet) <u>111</u>			
(3) static water level (feet) <u>78</u> below above top of ground.			
(4) casing <u>PVC</u> , <u>101</u> , (material) (depth) <u>4</u> if telescope see back. (size)			
(5) screen <u>10</u> , <u>101</u> (length) (depth to top) <u>4</u> , <u>PVC</u> (size) (material)			
(6) pump <u>1/2</u> , <u>10</u> (HP) (yield gpm) <u>elec</u> (type power)			
(7) electric log <u>no</u> (yes or no) <u>Land Shark</u> (organization running log)			
(8) how well bottom plugged <u>Land Shark</u>			


RECEIVED
AUG 13 1986

Department of Natural Resources
Bureau of Land & Water Resources

DRILLERS REMARKS:

If well telescopes please sketch and show depths.

GROUND LEVEL

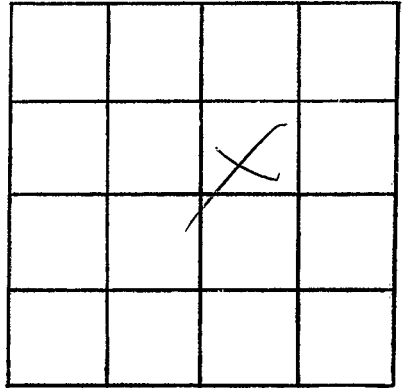

SECTION 5

Please indicate well location X.

ADDITIONAL INFORMATION

If more than one screen,
show locations of each on sketch.