

MISSISSIPPI DEPARTMENT OF NATURAL RESOURCES

Bureau of Land and Water Resources

Southport Mall

P.O. Box 10631

Jackson, Mississippi 39209

WATER WELL DRILLERS LOG

PIKE
CAJON

9-10

1986

Fitzgerald Well Serv. Co. Pike

date well completed

firm name

county well located

LANDOWNER:	description of formations encountered	from	to
<u>Sam Westbrook</u> <u>R.R. 1, Jayess, ms</u> (mailing address)	<u>Reel clay</u>	<u>0</u>	<u>20</u>
	<u>Reel gravel</u>	<u>20</u>	<u>60</u>
	<u>Reel sand</u>	<u>60</u>	<u>95</u>
	<u>Coarse sand & gravel</u>	<u>95</u>	<u>110</u>
WELL LOCATION: sec. <u>2</u> T <u>4</u> N R <u>9</u> E S W <u>5</u> miles <u>H</u> of <u>Pineblake</u> (distance) (direction) (nearest town)			
WELL PURPOSE: (home, irrigation, municipal, industrial) <u>Home</u>			
WELL COMPLETION DATA:			
(1) diameter (inches) <u>4</u>			
(2) total depth (feet) <u>110</u>			
(3) static water level (feet) <u>78</u> below top of ground.			
(4) casing <u>pvc 100</u> , (material) (depth) <u>4</u> if telescope see back. (size)			
(5) screen <u>10</u> , <u>100</u> (length) (depth to top) <u>2</u> , <u>pvc</u> (size) (material)			
(6) pump <u>1/2</u> , <u>10</u> (HP) (yield gpm) <u>elec</u> (type power)			
(7) electric log <u>No</u> (yes or no) <u></u> (organization running log)			
(8) how well bottom plugged <u>Sand Shok</u>			
DRILLERS REMARKS:			


RECEIVED

OCT 14 1986

Department of Natural Resources
Bureau of Land & Water Resources

If well telescopes please sketch and show depths.

GROUND LEVEL

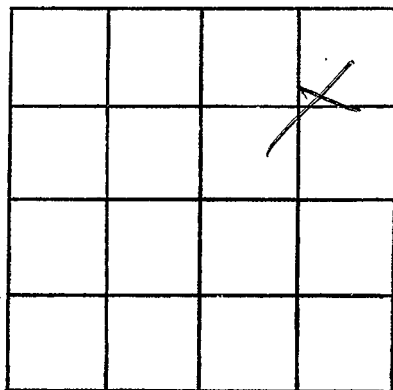

SECTION 2

Please indicate well location X.

ADDITIONAL INFORMATION

If more than one screen,
show locations of each on sketch.