

MISSISSIPPI DEPARTMENT OF NATURAL RESOURCES

Bureau of Land and Water Resources

Southport Mall

P.O. Box 10631

Jackson, Mississippi 39209

WATER WELL DRILLERS LOG

PIKE
C 2072

9-17 1986
date well completed

General Well Serv
firm name

Pike
county well located

LANDOWNER:	description of formations encountered	from	to
<u>O.C. Sullivan</u>	<u>Red clay</u>	<u>0</u>	<u>20</u>
<u>P.R. Jayess, m.s</u> (mailing address)	<u>Red sand</u>	<u>20</u>	<u>80</u>
WELL LOCATION: sec. <u>2</u> T <u>4</u> N R <u>9</u> E S W	<u>Coarse sand & gravel</u>	<u>80</u>	<u>92</u>
6 miles <u>N</u> of <u>Prentiss</u> (distance) (direction) (nearest town)			
WELL PURPOSE: <u>Home</u> (home, irrigation, municipal, industrial)			
WELL COMPLETION DATA:			
(1) diameter (inches) <u>4</u>			
(2) total depth (feet) <u>92</u>			
(3) static water level (feet) <u>45</u> below top of ground.			
(4) casing <u>PVC</u> , <u>82</u> (material) (depth) <u>4</u> (size) if telescope see back.			
(5) screen <u>10</u> , <u>82</u> (length) (depth to top) <u>4</u> (size) <u>PVC</u> (material)			
(6) pump <u>1/2</u> , <u>10</u> (HP) (yield gpm) <u>Elco</u> (type power)			
(7) electric log <u>No</u> (yes or no)			
(8) how well bottom plugged <u>Sand plug</u> (organization running log)			
DRILLERS REMARKS:			


RECEIVED

OCT 14 1986

Department of Natural Resources
Bureau of Land & Water Resources

If well telescopes please sketch and show depths.

GROUND LEVEL

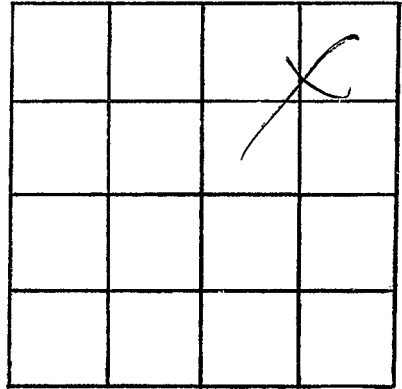

SECTION 2

Please indicate well location X.

ADDITIONAL INFORMATION

If more than one screen,
show locations of each on sketch.