

MISSISSIPPI DEPARTMENT OF NATURAL RESOURCES

Bureau of Land and Water Resources

P.O. Box 10631

Jackson, Mississippi 39209

WATER WELL DRILLERS LOG

COUNTY WELL LOCATED PIKE	
WELL NUMBER C	CODED
2094	
DATE WELL COMPLETED NOV 9-87	

PERMIT NUMBER
NAME OF DRILLING FIRM FITZGERALD
well service

NAME & MAILING ADDRESS OF LANDOWNER JOHN DOTHRELLE		
RT 1 Summit MS		
WELL LOCATION: SEC	TOWNSHIP	RANGE
2	29	4 N 9 E
DISTANCE	DIRECTION	NEAREST TOWN
2 Miles	W	of Pricedale
OTHER LANDMARK		
WELL PURPOSE: Home, Irrigation, Municipal, Industrial, Fish Pond, etc. Home		

PUMP DATA		
PUMP TYPE (Circle One): <input checked="" type="radio"/> Submersible, Turbine, Jet, Flowing Well, Other (Describe) _____		
POWER TYPE (Circle One): <input checked="" type="radio"/> Electric, Tractor, Diesel, Gasoline, Butane, Other (Describe) _____		
Pump Capacity (GPM) 10	No. of Stages 10	Setting Depth 155 FT.
PUMP TEST		
Well yielded 10 GPM with a drawdown of 4 ft. after 6 hours of pumping		


WELL DATA		
Well Depth 170	Casing Diameter (In.) 4	Casing Length (Ft.) 160
Type of Casing POC	Hole Depth 170	Depth to Static Water Level 130
TYPE OF COMPLETION: (Circle One or More): <input checked="" type="checkbox"/> Gravel Packed, <input type="checkbox"/> Underreamed, <input type="checkbox"/> Telescoped, <input type="checkbox"/> Natural Development, <input type="checkbox"/> Open Hole, <input type="checkbox"/> Other (Describe) _____		
Top of Lap Pipe or Reduction in Casing FEET IF TELESCOPED OR MORE THAN ONE SCREEN: USE BACK PAGE		

LOG DATA	
TYPE OF LOG RUN (Circle One): <input checked="" type="radio"/> No Log Run, <input type="radio"/> Electric, Gamma Ray, Density, Sonic, Neutron, Other (Describe) _____	
Name of Organization Running Log	

SCREEN DATA		
Diameter - Inches 4	Length - Feet 10	Slot Size - Inches 1014
Screen Type POC	Depth to Bottom - Feet 170	

GEOLOGIC DATA (Office Use Only)			
Surface Elev.	Geologic Unit	Unit Thickness	Depth to Top
Subs. SWL	Date	Analysis	Aquifer Test


Driller's Remarks

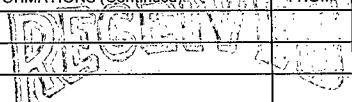DESCRIPTION OF FORMATIONS ENCOUNTERED	FROM	TO	FORMATIONS (Continued)	FROM	TO
Red CLAY	0	20	 JAN 8 1988 Department of Natural Resources Bureau of Land & Water Resources		
Red SAND	20	120			
FINE SAND	120	155			
COURSE SAND & GRAVEL	155	170			

IF MORE SPACE IS NEEDED, USE BACK

If well telescopes please sketch and show depths.

GROUND LEVEL

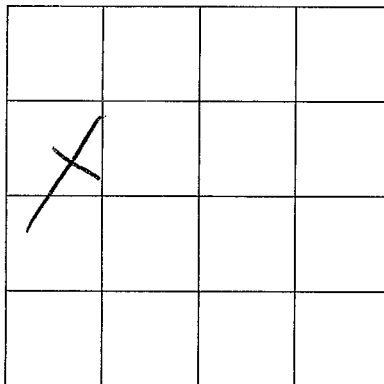

SECTION 29

Please indicate well location X.

ADDITIONAL INFORMATION

If more than one screen, show location of each on sketch.