

MISSISSIPPI DEPARTMENT OF NATURAL RESOURCES

Bureau of Land and Water Resources

Southport Mall

P.O. Box 10631

Jackson, Mississippi 39209

WATER WELL DRILLERS LOG

PIKE
C 2103

Nov 11 1989 *F. L. ...* *Pike*
 date well completed firm name county, well located


LANDOWNER:	description of formations encountered	from	to
<i>Mike Ramsey</i>			
<i>RR- Jones, Mrs.</i> (mailing address)	<i>Red Clay</i>	<i>0</i>	<i>15</i>
	<i>White Chalk</i>	<i>15</i>	<i>74</i>
	<i>Coarse sandstone</i>	<i>74</i>	<i>90</i>
WELL LOCATION:			
sec. <i>21</i> T- <i>4</i> N R- <i>9</i> E S W			
<i>1/2</i> miles <i>H</i> of <i>Prichard</i> (distance) (direction) (nearest town)			
WELL PURPOSE:			
<i>Home</i> (home, irrigation, municipal, industrial)			
WELL COMPLETION DATA:			
(1) diameter (inches) <i>4</i>			
(2) total depth (feet) <i>90</i>			
(3) static water level (feet) <i>55</i> below top of ground. above			
(4) casing <i>pvc 80</i> (material) (depth)			
<i>4</i> (size) if telescope see back.			
(5) screen <i>10 80</i> (length) (depth to top)			
<i>4</i> <i>pvc</i> (size) (material)			
(6) pump <i>1/2 10</i> (HP) (yield gpm)			
<i>elec</i> (type power)			
(7) electric log <i>no</i> (yes or no)			
<i>/</i> (organization running log)			
(8) how well bottom plugged <i>Sand Shnk</i>			
DRILLERS REMARKS:			

RECEIVED
 DEC 11 1989

Department of Natural Resources
 Bureau of Land & Water Resources

If well telescopes please sketch and show depths.

GROUND LEVEL

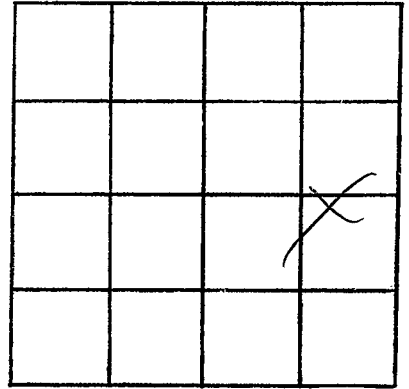

SECTION 21

Please indicate well location X.

ADDITIONAL INFORMATION

If more than one screen,
show locations of each on sketch.