

PIKE
CA108

MISSISSIPPI DEPARTMENT OF NATURAL RESOURCES
Bureau of Land and Water Resources
Southport Mall
P.O. Box 10631
Jackson, Mississippi 39209
WATER WELL DRILLERS LOG

Aug 6 1990 F. Gould Well Serv Pike
date well completed firm name county well located

LANDOWNER:	description of formations encountered	from	to
<u>John M. Ewen</u>			
<u>R.R. Keith Mrs.</u> (mailing address)	<u>Red clay</u> <u>fine sand</u> <u>coarse sand & gravel</u>	<u>7</u> <u>10</u> <u>82</u>	<u>10</u> <u>82</u> <u>99</u>
WELL LOCATION: sec. <u>8</u> T <u>4</u> N R <u>9</u> E S W <u>1/2</u> miles <u>E</u> of <u>Felders</u> (distance) (direction) (nearest town)			
WELL PURPOSE: (home, irrigation, municipal, industrial) <u>Home</u>			
WELL COMPLETION DATA: (1) diameter (inches) <u>4</u> (2) total depth (feet) <u>99</u> (3) static water level (feet) <u>15</u> below above-top of ground. (4) casing <u>PVC</u> <u>89</u> (material) (depth) <u>4</u> if telescope see back. (size) (5) screen <u>10</u> <u>89</u> (length) (depth to top) <u>4</u> <u>PVC</u> (size) (material) (6) pump <u>1/2</u> <u>10</u> (HP) (yield gpm) <u>elec</u> (type power) (7) electric log <u>no</u> (yes or no) (organization running log) (8) how well bottom plugged <u>bullet</u>			
DRILLERS REMARKS:			


RECEIVED

AUG 17 1990

Department of Natural Resources
Bureau of Land & Water Resources

If well telescopes please sketch and show depths.

GROUND LEVEL

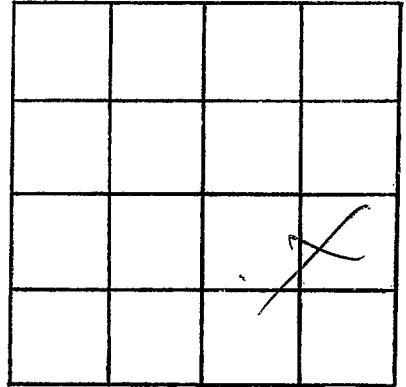

SECTION 8

Please indicate well location X.

ADDITIONAL INFORMATION

If more than one screen,
show locations of each on sketch.