

MISSISSIPPI DEPARTMENT OF ENVIRONMENTAL QUALITY

Office of Land and Water Resources

P. O. Box 10631
Jackson, MS 39289-0631
WATER WELL DRILLERS LOG

COUNTY WELL LOCATED PIKE	
WELL NUMBER C	CODED
DATE WELL COMPLETED 2/15 3-30-93	

PERMIT NUMBER
NAME OF DRILLING FIRM Fitzgerald Well Serv

NAME & MAILING ADDRESS OF LANDOWNER Robbie Travis		
RR. 1 Jayess, MS.		
WELL LOCATION: SEC	TOWNSHIP	RANGE
10	4	9
	N	E
	S	W
DISTANCE	DIRECTION	NEAREST TOWN
3 Miles	N	of PRicedale
OTHER LANDMARK		
WELL PURPOSE: Home, Irrigation, Municipal, Industrial, Fish Pond, etc. Home		

PUMP DATA		
PUMP TYPE (Circle One): <input checked="" type="checkbox"/> Submersible, Turbine, Jet, Flowing Well, Other (Describe) _____		
POWER TYPE (Circle One): <input checked="" type="checkbox"/> Electric, Tractor, Diesel, Gasoline, Butane, Other (Describe) _____ H/P 3/4		
Pump Capacity (GPM) 15	No. of Stages 12	Setting Depth 100 FT.
PUMP TEST		
Well yielded 40 GPM with a drawdown of 2 ft. after 2 hours of pumping		

WELL DATA		
Well Depth 118	Casing Diameter (In.) 4	Casing Length (Ft.) 108
Type of Casing PIC	Hole Depth 118	Depth to Static Water Level 75
TYPE OF COMPLETION: (Circle One or More): <input checked="" type="checkbox"/> Gravel Packed, Underreamed, Telescoped, <input checked="" type="checkbox"/> Natural Development, Open Hole, Other (Describe) _____		

LOG DATA	
TYPE OF LOG RUN (Circle One): Electric, Gamma Ray, Density, Sonic, <input checked="" type="checkbox"/> Neutron, Other (Describe) _____	
Name of Organization Running Log	

WELL GROUTED TO A DEPTH OF 10 FEET
Type Grout (circle one): Cement, Bentonite, or Mix

GEOLOGIC DATA (Office Use Only)			
Surface Elev.	Geologic Unit	Unit Thickness	Depth to Top
Subs. SWL	Date	Analysis	Aquifer Test

SCREEN DATA		
Diameter - Inches 4	Length - Feet 10	Slot Size - Inches 1014
Screen Type no L	Depth to Bottom - Feet 118	


Driller's Remarks

DESCRIPTION OF FORMATIONS ENCOUNTERED	FROM	TO	FORMATIONS (Continued)	FROM	TO
Red Clay	0	20	RECEIVED MAY 25 1993 Dept. of Environmental Quality Office of Land & Water Resources		
Red SAND	20	103			
COURSE SAND & GRAVEL	103	118			

IF MORE SPACE IS NEEDED, USE BACK

If well telescopes please sketch and show depths.

GROUND LEVEL

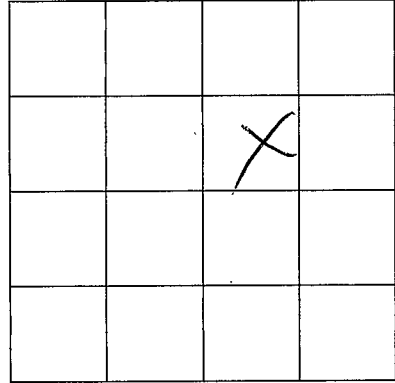

SECTION 10

Please indicate well location X.

ADDITIONAL INFORMATION

If more than one screen, show location of each on sketch.