

MISSISSIPPI DEPARTMENT OF ENVIRONMENTAL QUALITY

Office of Land and Water Resources

P. O. Box 10631
Jackson, MS 39289-0631

WATER WELL DRILLERS LOG

COUNTY WELL LOCATED PIKE	
WELL NUMBER 1	CODED
C 2121	
DATE WELL COMPLETED 8-20-93	

PERMIT NUMBER 0-402
NAME OF DRILLING FIRM Tom Griffith
Water Well

NAME & MAILING ADDRESS OF LANDOWNER JACK HANKINS		
P.O. Box 116		
Grand Ledge La 70358		
WELL LOCATION: SEC	TOWNSHIP	RANGE
31	4	9
DISTANCE DIRECTION NEAREST TOWN 6 Miles E of McComb		
OTHER LANDMARK		
WELL PURPOSE: Home, Irrigation, Municipal, Industrial, Fish Pond, etc. Chicken Houses		

PUMP DATA		
PUMP TYPE (Circle One): <u>Submersible</u> Turbine, Jet, Flowing Well, Other (Describe) _____		
POWER TYPE (Circle One): <u>Electric</u> Tractor, Diesel, Gasoline, Butane, Other (Describe) _____ H/P 1/2		
Pump Capacity (GPM) 25	No. of Stages	Setting Depth 75 FT.
PUMP TEST Air Lift		
Well yielded 90 GPM with a drawdown of _____ ft. after _____ hours of pumping		

WELL DATA		
Well Depth 100	Casing Diameter (In.) 4	Casing Length (Ft.) 80
Type of Casing PVC	Hole Depth 100	Depth to Static Water Level 22

LOG DATA	
TYPE OF LOG RUN (Circle One): No Log Run, Electric, Gamma Ray, Density, Sonic, Neutron, Other (Describe) _____	
Name of Organization Running Log	

TYPE OF COMPLETION: (Circle One or More):
Gravel Packed, Underreamed, Telescoped,
Natural Development, Open Hole, Other

WELL GROUTED TO A DEPTH OF **10** FEET
Type Grout (circle one): Cement, Bentonite, or Mix

SCREEN DATA		
Diameter - Inches 4	Length - Feet 20	Slot Size - Inches 20/10
Screen Type PVC		Depth to Bottom - Feet 0


GEOLOGIC DATA (Office Use Only)			
Surface Elev.	Geologic Unit	Unit Thickness	Depth to Top
Subs. SWL	Date	Analysis	Aquifer Test
Driller's Remarks			

DESCRIPTION OF FORMATIONS ENCOUNTERED	FROM	TO
CLAY	1	30
GRAVEL	30	60
SAND & P-GRAVEL	60	100

FORMATIONS (Continued)		FROM	TO
RECEIVED			
JUL 02 1993			
Dept. of Environmental Quality Office of Land & Water Resources			
IF MORE SPACE IS NEEDED, USE BACK			

If well telescopes please
sketch and show depths.

GROUND LEVEL

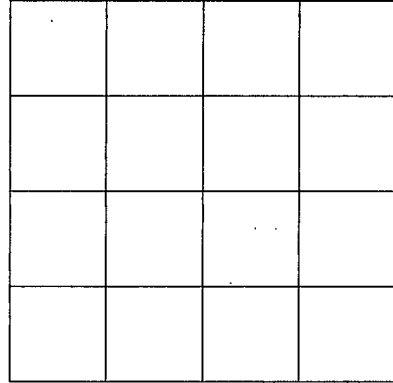

SECTION _____

Please indicate well location X.

ADDITIONAL INFORMATION

If more than one screen,
show location of each on sketch.