

**MISSISSIPPI DEPARTMENT OF ENVIRONMENTAL QUALITY**

Office of Land and Water Resources

P. O. Box 10631  
Jackson, MS 39289-0631  
**WATER WELL DRILLERS LOG**

COUNTY WELL LOCATED <i>Pike</i>	
WELL NUMBER <i>C</i>	CODED
DATE WELL COMPLETED <i>2/25</i> <i>APR 27/95</i>	

PERMIT NUMBER
NAME OF DRILLING FIRM <i>FITZGERALD well SERV</i>

NAME & MAILING ADDRESS OF LANDOWNER <i>Billy Henning</i> <i>RR. Summit ms</i>			
WELL LOCATION:	SEC <i>30</i>	TOWNSHIP <i>4 N</i>	RANGE <i>9 E</i>
DISTANCE	DIRECTION	NEAREST TOWN	
<i>7</i> Miles	<i>E</i>	of <i>McComb</i>	
OTHER LANDMARK			
WELL PURPOSE: <input checked="" type="checkbox"/> Home, <input type="checkbox"/> Irrigation, <input type="checkbox"/> Municipal, <input type="checkbox"/> Industrial, <input type="checkbox"/> Fish Pond, etc.			

PUMP DATA		
PUMP TYPE (Circle One): <input checked="" type="checkbox"/> Submersible, <input type="checkbox"/> Turbine, <input type="checkbox"/> Jet, <input type="checkbox"/> Flowing Well, Other (Describe) _____		
POWER TYPE (Circle One): <input checked="" type="checkbox"/> Electric, <input type="checkbox"/> Tractor, <input type="checkbox"/> Diesel, <input type="checkbox"/> Gasoline, <input type="checkbox"/> Butane, Other (Describe) _____ H/P <i>1/2</i>		
Pump Capacity (GPM) <i>10</i>	No. of Stages <i>9</i>	Setting Depth <i>130'</i> FT.
PUMP TEST		
Well yielded <i>25</i> GPM with a drawdown of <i>2</i> ft. after <i>2</i> hours of pumping		

WELL DATA		
Well Depth <i>188</i>	Casing Diameter (In.) <i>4</i>	Casing Length (Ft.) <i>178</i>
Type of Casing <i>PIC</i>	Hole Depth <i>188</i>	Depth to Static Water Level <i>100</i>

LOG DATA	
TYPE OF LOG RUN (Circle One): Electric, Gamma Ray, Density, Sonic, <input checked="" type="checkbox"/> No Log Run, Neutron, Other (Describe) _____	
Name of Organization Running Log	

TYPE OF COMPLETION: (Circle One or More): <input checked="" type="checkbox"/> Gravel Packed, <input type="checkbox"/> Underreamed, <input type="checkbox"/> Telescoped, <input type="checkbox"/> Natural Development, <input type="checkbox"/> Open Hole, <input type="checkbox"/> Other (Describe)			
--	--	--	--

GEOLOGIC DATA (Office Use Only)			
Surface Elev.	Geologic Unit	Unit Thickness	Depth to Top
Subs. SWL	Date	Analysis	Aquifer Test
Driller's Remarks			

WELL GROUTED TO A DEPTH OF <i>10</i> FEET
Type Grout (circle one): Cement, Bentonite, <input checked="" type="checkbox"/> Mix


SCREEN DATA		
Diameter - Inches <i>4</i>	Length - Feet <i>10</i>	Slot Size - Inches <i>1012</i>
Screen Type <i>PIC</i>	Depth to Bottom - Feet <i>188</i>	

DESCRIPTION OF FORMATIONS ENCOUNTERED	FROM	TO	FORMATIONS (Continued)	FROM	TO
<i>Red Clay</i>	<i>0</i>	<i>20</i>	<b>RECEIVED</b>  <b>JUN 14 1995</b>  Dept. of Environmental Quality Office of Land & Water Resources		
<i>Red sand</i>	<i>20</i>	<i>95</i>			
<i>White clay</i>	<i>95</i>	<i>174</i>			
<i>Course sand</i>	<i>174</i>	<i>188</i>			

IF MORE SPACE IS NEEDED, USE BACK

If well telescopes please  
sketch and show depths.

GROUND LEVEL

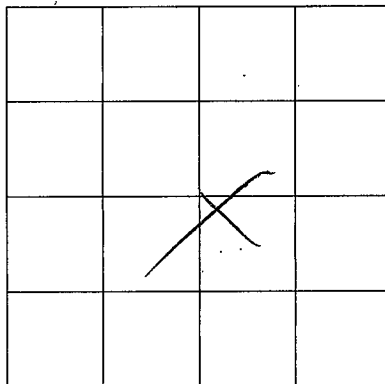

SECTION 30

Please indicate well location X.

ADDITIONAL INFORMATION

If more than one screen,  
show location of each on sketch.