

MISSISSIPPI DEPARTMENT OF ENVIRONMENTAL QUALITY

Office of Land and Water Resources

P. O. Box 10631
Jackson, MS 39289-0631
WATER WELL DRILLERS LOG

COUNTY WELL LOCATED Pike	
WELL NUMBER C 2135	CODED
DATE WELL COMPLETED 11-24-98	

PERMIT NUMBER
NAME OF DRILLING FIRM Fitzgerald Well

NAME & MAILING ADDRESS OF LANDOWNER Louis Guidry, Lowart Price Rd.		
WELL LOCATION: SEC	TOWNSHIP	RANGE
27	4	9
	N S	E W
DISTANCE 9 Miles	DIRECTION EAST	NEAREST TOWN McComb
OTHER LANDMARK		
WELL PURPOSE: <input checked="" type="radio"/> Home Irrigation, Municipal, Industrial, Fish Pond, etc.		

PUMP DATA		
PUMP TYPE (Circle One): <input checked="" type="radio"/> Submersible Turbine, Jet, Flowing Well, Other (Describe) _____		
POWER TYPE (Circle One): <input checked="" type="radio"/> Electric, Tractor, Diesel, Gasoline, Butane, Other (Describe) _____ H/P 12		
Pump Capacity (GPM) 12	No. of Stages 9	Setting Depth 100 FT.
PUMP TEST Well yielded _____ GPM with a drawdown of _____ ft. after _____ hours of pumping		

WELL DATA		
Well Depth 136'	Casing Diameter (In.) 4"	Casing Length (Ft.) 126'
Type of Casing Pvc	Hole Depth 136'	Depth to Static Water Level 68'
TYPE OF COMPLETION: (Circle One or More): <input checked="" type="radio"/> Gravel Packed, Underreamed, Telescoped, Natural Development, Open Hole, Other (Describe) _____		
WELL GROUTED TO A DEPTH OF 10 FEET Type Grout (circle one): Cement, Bentonite, or <input checked="" type="radio"/> Mix		

LOG DATA	
TYPE OF LOG RUN (Circle One): No Log Run, Electric, Gamma Ray, Density, Sonic, Neutron, Other (Describe) _____	
Name of Organization Running Log	

SCREEN DATA		
Diameter - Inches 4"	Length - Feet 10	Slot Size - Inches .010
Screen Type Pvc	Depth to Bottom - Feet 136'	

GEOLOGIC DATA (Office Use Only)			
Surface Elev.	Geologic Unit	Unit Thickness	Depth to Top
Subs. SWL	Date	Analysis	Aquifer Test
Driller's Remarks			
Top of Lap Pipe or Reduction in Casing			
FEET		IF TELESCOPED OR MORE THAN ONE SCREEN: USE BACK PAGE	

DESCRIPTION OF FORMATIONS ENCOUNTERED	FROM	TO	FORMATIONS (Continued)		
			FROM	TO	
Top soil	0	5			
Sand & gravel	5	40			
clay	40	50			
sand & gravel	50	80			
clay	80	100			
Sand	100	120			
coarse sand	120	136			

RECEIVED


JAN 13 1999

Dept. of Environmental Quality
Office of Land & Water Resources

IF MORE SPACE IS NEEDED, USE BACK

If well telescopes please
sketch and show depths.

GROUND LEVEL

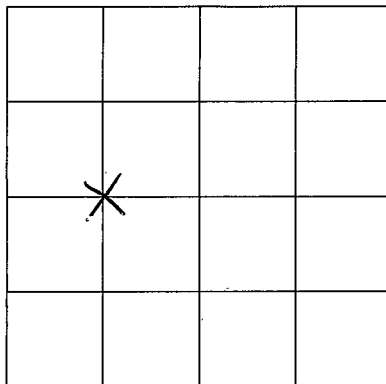

SECTION _____

Please indicate well location X.

ADDITIONAL INFORMATION

If more than one screen,
show location of each on sketch.