

MISSISSIPPI DEPARTMENT OF ENVIRONMENTAL QUALITY

Office of Land and Water Resources

P. O. Box 10631
Jackson, MS 39289-0631
WATER WELL DRILLERS LOG

COUNTY WELL LOCATED PIKE	
WELL NUMBER C-2137	CODED
DATE WELL COMPLETED 11-29-99	

PERMIT NUMBER 0-287
NAME OF DRILLING FIRM REEVES WELL SET

NAME & MAILING ADDRESS OF LANDOWNER JOE BAILOCK		
1085 Teel Thompson Rd.		
Summit		
MISS		
WELL LOCATION: SEC	TOWNSHIP	RANGE
29	4	9
DISTANCE	DIRECTION	NEAREST TOWN
2 Miles	W	PRICEDALE
OTHER LANDMARK		
WELL PURPOSE: <u>Home</u> , Irrigation, Municipal, Industrial, Fish Pond, etc.		

PUMP DATA		
PUMP TYPE (Circle One): Submersible, Turbine, Jet, Flowing Well, Other (Describe)		
POWER TYPE (Circle One): <input checked="" type="checkbox"/> Electric, Tractor, Diesel, Gasoline, Butane, Other (Describe) <u>H/P</u>		
Pump Capacity (GPM) 20	No. of Stages 14	Setting Depth 140 FT.
PUMP TEST		
Well yielded 60 GPM with		
a drawdown of 0 ft.		
after 1 hours of pumping		

WELL DATA		
Well Depth 156'	Casing Diameter (In.) 4"	Casing Length (Ft.) 20'
Type of Casing PVC	Hole Depth 156'	Depth to Static Water Level 100'
TYPE OF COMPLETION: (Circle One or More): Gravel Packed, Underreamed, Telescoped, Natural Development, Open Hole, Other (Describe) 10 GAL SAND		
WELL GROUTED TO A DEPTH OF 10 FEET Type Grout (circle one): <u>Cement</u> , Bentonite, or Mix		

LOG DATA	
TYPE OF LOG RUN (Circle One): No Log Run, Electric, Gamma Ray, Density, Sonic, Neutron, Other (Describe)	
Name of Organization Running Log	

SCREEN DATA		
Diameter - Inches 4"	Length - Feet 10'	Slot Size - Inches 10 SLOT
Screen Type PVC	Depth to Bottom - Feet 156'	

GEOLOGIC DATA (Office Use Only)			
Surface Elev.	Geologic Unit	Unit Thickness	Depth to Top
Subs. SWL	Date	Analysis	Aquifer Test


Driller's Remarks REC'D JAN 03 2002	
Top of Lap Pipe or Reduction in Casing FEET IF TELESKOPED OR MORE THAN ONE SCREEN: USE BACK PAGE	

DESCRIPTION OF FORMATIONS ENCOUNTERED	FROM	TO	FORMATIONS (Continued)	FROM	TO
CLAY	0	15			
SAND	15	30			
SAND & GRAVEL	30	100			
LOBLY SAND	100	130			
SAND & GRAVEL	130	156			

IF MORE SPACE IS NEEDED, USE BACK

If well telescopes please sketch and show depths.

GROUND LEVEL

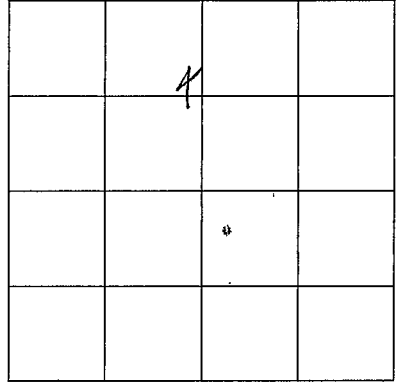

SECTION 29

Please indicate well location X.

ADDITIONAL INFORMATION

If more than one screen,
show location of each on sketch.