

MISSISSIPPI DEPARTMENT OF ENVIRONMENTAL QUALITY

Office of Land and Water Resources

P. O. Box 10631  
Jackson, MS 39289-0631  
WATER WELL DRILLERS LOG

COUNTY WELL LOCATED  
Pike

WELL NUMBER C-2141 CODED

DATE WELL COMPLETED  
6-19-02

PERMIT NUMBER

NAME OF DRILLING FIRM  
Fitzgerald Well Service

NAME & MAILING ADDRESS OF LANDOWNER  
Tommy Myers,  
West Topisau Rd.

Latitude:  
Longitude:

WELL LOCATION. SEC 17 TOWNSHIP 9 N RANGE 9 E

DISTANCE 8 Miles East DIRECTION of McComb NEAREST TOWN

OTHER LANDMARK

WELL PURPOSE: Home, Irrigation, Municipal, Industrial, Fish Pond, etc.  
chicken house.

PUMP DATA

PUMP TYPE (Circle One):  
 Submersible,  Turbine,  Jet  Flowing Well,  
Other (Describe)

POWER TYPE (Circle One):  
 Electric,  Tractor,  Diesel,  Gasoline,  Butane,  
Other (Describe) H/P

DESCRIPTION OF FORMATIONS ENCOUNTERED	FROM	TO
<u>clay</u>	<u>0</u>	<u>20</u>
<u>sand &amp; gravel</u>	<u>20</u>	<u>80</u>
<u>clay</u>	<u>80</u>	<u>90</u>
<u>sand</u>	<u>90</u>	<u>120</u>
<u>course sand &amp; gravel</u>	<u>120</u>	<u>140</u>

RECEIVED

JUL 22 2002

BY: OLWF

Top of Lap Pipe or Reduction in Casing

FEET  IF TELESCOPED OR MORE THAN ONE SCREEN: USE BACK PAGE

WELL DATA

Well Depth - 140' Casing Diameter (In.) 4" Casing Length (Ft.) 120'

Type of Casing PVC Hole Depth 140' Depth to Static Water Level 70'

TYPE OF COMPLETION: (Circle One or More):  
 Gravel Packed,  Underreamed,  Telescoped,  
 Natural Development,  Open Hole,  Other  
(Describe)

WELL GROUTED TO A DEPTH OF 10 FEET  
Type Grout (circle one): Cement, Bentonite, or  Mix

SCREEN DATA

Diameter - Inches 4" Length - Feet 20' Slot Size - Inches .012/010

Screen Type PVC Depth to Bottom - Feet 140'

I certify that the well was drilled, constructed and completed in accordance with all applicable Requirements of the Mississippi Department of Environmental Quality and/or the Mississippi Department of Health regulations and state laws.


Bruce Fitzgerald 0291  
Signature of Licensed Driller and License No.

7-15-02  
Date

Additional Information Required On Back

If well telescopes please sketch and show depths.

GROUND LEVEL

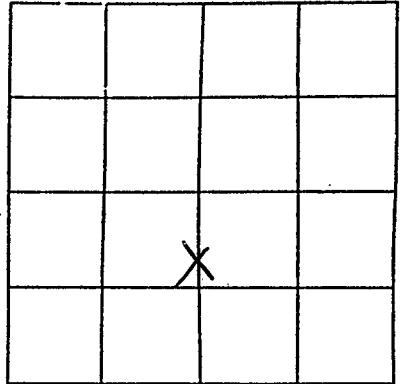

SECTION 17

Please indicate well location X.

Pump Capacity (GPM)	No. of Stages	Setting Depth
<u>27</u>		<u>120'</u> FT.
PUMP TEST		
Well yielded _____ GPM with a drawdown of _____ ft. after _____ hours of pumping		

LOG DATA

TYPE OF LOG RUN (Circle One):  No Log Run,  Electric,  Gamma Ray,  Density,  Sonic,  Neutron,  Other (Describe) \_\_\_\_\_

Name of Organization Running Log \_\_\_\_\_

GEOLOGIC DATA (Office Use Only)

Surface Elev.	Geologic Unit	Unit Thickness	Depth to Top
Subs. SWL	Date	Analysis	Aquifer Test

Driller's Remarks

\_\_\_\_\_

\_\_\_\_\_

If more than one screen, show location of each on sketch.