

PIKE  
D  
7-10-74

MISSISSIPPI  
BOARD OF WATER COMMISSIONERS  
416 North State Street  
Jackson, Mississippi 39201 CODED

WATER WELL DRILLERS LOG

7-10 1974 Fitzgerald Well Drilling Pike  
date well completed firm name county well located

LANDOWNER:

Fremont McKinley

B.R. McComb Miss  
(mailing address)

description of formations encountered

from to

<u>Red Clay</u>	<u>0</u>	<u>10</u>
<u>Red Gravel</u>	<u>10</u>	<u>60</u>
<u>Common Soil &amp; gravel</u>	<u>60</u>	<u>98</u>

WELL LOCATION:

sec. 20 T. 3 N. R. 7 E.  
3 miles W of McComb  
(distance) (direction) (nearest town)

WELL PURPOSE: Home  
(home, irrigation, municipal, industrial)

WELL COMPLETION DATA:

- (1) diameter (inches) 4
- (2) total depth (feet) 98
- (3) static water level (feet) 50 below above top of ground.
- (4) casing plastic, 90,  
(material) (depth)  
4 if telescope see back.  
(size)
- (5) screen 8, 90  
(length) (depth to top)  
4, plastic  
(size) (material)
- (6) pump 1 20  
(HP) (yield gpm)  
elec  
(type power)
- (7) electric log no  
(yes or no)  
(organization running log)
- (8) how well bottom plugged sand blk


DRILLERS REMARKS:

REGISTERED  
MAY 26 1974

MISS. Bd. OF WATER COMMISSIONERS

If well telescopes please sketch and show depths.

GROUND LEVEL

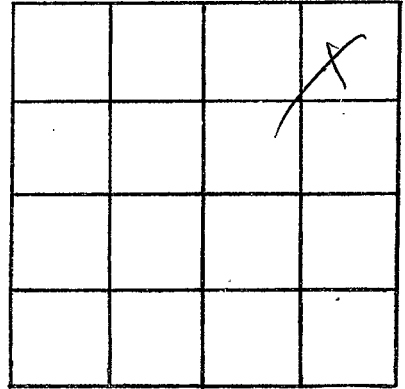

SECTION 20

Please indicate well location X.

ADDITIONAL INFORMATION

If more than one screen,  
show locations of each on sketch.