

**MISSISSIPPI
BOARD OF WATER COMMISSIONERS**
416 North State Street
Jackson, Mississippi 39201

WATERWELL DRILLERS LOG

Aug 5 1970 Chester Deere Pike
date well completed firm name county well located

LANDOWNER: Paul Dickerson
Rt 3, Summit
(mailing address)

WELL LOCATION:
sec. 10 T. 3 N. R. 7 E.
1 miles SW of McComb
(distance) (direction) (nearest town)

WELL PURPOSE: Same
(home, irrigation, municipal, industrial)

WELL COMPLETION DATA:

- (1) diameter (inches) 4"
- (2) total depth (feet) 79
- (3) static water level (feet) 51 below top of ground.
- (4) casing Hard Bottom
(material) (depth)
- (5) screen 6' 73'
(size) (length) (depth in top)
- (6) pump 1/2 HP Plastic
(HP) (material)
- (7) electric log NO
(yes or no)
- (8) how well bottom plugged wooden plug

description of formations encountered	depth	
	from	to
<u>clay</u>	<u>0</u>	<u>15</u>
<u>red sand</u>	<u>15</u>	<u>54</u>
<u>red chalk</u>	<u>54</u>	<u>68</u>
<u>sand & gravel</u>	<u>68</u>	<u>79</u>


Pipe pulled and this well abandoned - another well drilled Aug 27, 1970

DRILLERS REMARKS: This well salty

SEP 21 1970

If well telescopes please sketch and show depths.

GROUND LEVEL

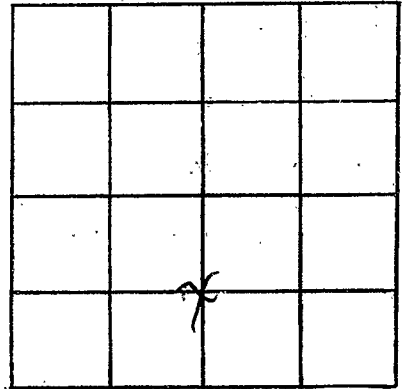

SECTION _____

Please indicate well location X.

ADDITIONAL INFORMATION

If more than one screen,
show locations of each on sketch.