

Pike CODED
 D15
 6-60

MISSISSIPPI
 BOARD OF WATER COMMISSIONERS
 416 North State Street
 Jackson, Mississippi 39201

WATER WELL DRILLERS LOG

6-15 1966 Fitzgerald Water Well Serv Pike
 date well completed firm name county well located

LANDOWNER: Percy Quinn Park
R3 McPomb, Miss
 (mailing address)

WELL LOCATION:
 sec. 32 T. 3 N. R. 7 E
7 miles SW of McPomb
 (distance) (direction) (nearest town)


WELL PURPOSE: Lodge
 (home, irrigation, municipal, industrial)

WELL COMPLETION DATA:

- (1) diameter (inches) 4
- (2) total depth (feet) 110
- (3) static water level (feet) 55 below above top of ground.
- (4) casing plastic, 90'
 (material) (depth)
4 if telescope see back.
 (size)
- (5) screen 16', 90'
 (length) (depth to top)
4, plastic
 (size) (material)
- (6) pump 3 1/2 - 35
 (HP) (yield gpm)
elec
 (type power)
- (7) electric log No
 (yes or no)
 (organization running log)
- (8) how well bottom plugged Wood peg


DRILLERS REMARKS:

description of formations encountered	from	to
top soil & clay	0	12
fine gravel	18	30
coarse gravel	20	50
Red Chalk	5	55
Sandy gravel	15	70
Soupy Sand	23	93
gravel	17	110
Red Chalk	10	

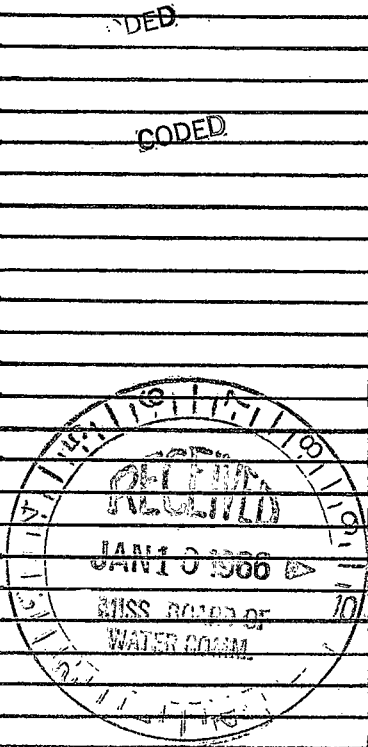

If well telescopes please sketch and show depths.

GROUND LEVEL

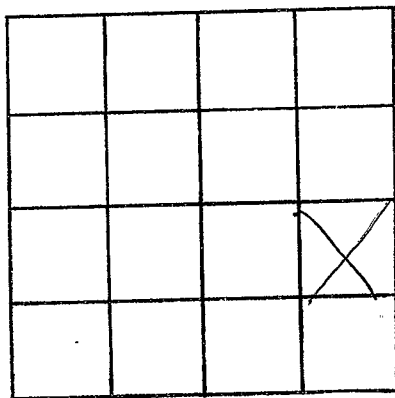

SECTION _____

Please indicate well location X.

ADDITIONAL INFORMATION

If more than one screen,
show locations of each on sketch.