

PIKE

MISSISSIPPI BOARD OF WATER COMMISSIONERS

A-D 16 CODED

11-8-65

WATER WELL DRILLERS LOG

Date: 11-8, 1965, Driller: J. T. Covington & Son County Pike  
(Name)


(1) Owner of Land: R. L. Boggan  
(Name)  
R. F. D. Summit, Miss  
(Address)  
3 1/2  
 (2) Location: 1/4, 1/4, Sec. 3 TR 7  
4 miles 5/8 west of Summit  
(distance) (direction) (Nearest Town)  
 (3) Topography: Hilly  
(Hilly) (Flat) (Level)  
 (4) Purpose of Well: Domestic  
(Domestic Irrigation Municipal, Industrial, Other)

Description & Color of Materials Sand, Clay, Red Clay, Shell, etc.	Thick-ness Feet	Depth Feet
<u>Sandy Clay</u>	<u>40</u>	<u>40</u>
<u>Sand Rock Chalk</u>	<u>35</u>	<u>75</u>
<u>Sand &amp; Rock</u>	<u>15</u>	<u>90</u>
<u>Chalk</u>	<u>120</u>	<u>210</u>
<u>Sands</u>	<u>38</u>	<u>248</u>

Information upon completion of well:

(1) Diameter 4" inches.  
 (2) Total Depth 248' feet.  
 (3) Water Level 80' feet below top of ground.  
 (4) Cased to 248', Size 4"  
 (5) Screen: Size 4", Length 6'  
 (6) Were any formations sealed against pollution?  
 \_\_\_\_\_ yes,  no.

CODED

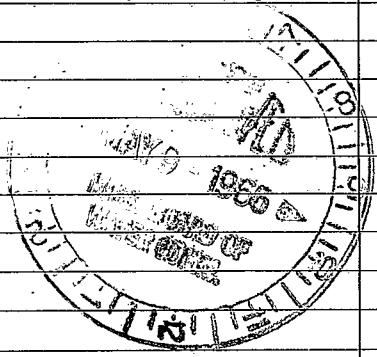

If YES depth of formation \_\_\_\_\_  
 Why \_\_\_\_\_  
 Drillers Remarks: \_\_\_\_\_

Well No.

(Use Back Side)

