

PIKE

MISSISSIPPI BOARD OF WATER COMMISSIONERS

D 18 CODED

7-13-60

WATER WELL DRILLERS LOG

301

Date: 7-13, 1960, Driller: Choctaw County, Pike

Republic Well & Pump Co. (Name)

(1) Owner of Land: M. Reichman (Name)
RFD 3, Mt. Lamb (Address)

(2) Location: 1/4, 1/4, Sec. 24, T3R7, 16 miles south of Mt. Lamb (direction) (Nearest Town)

(3) Topography: Hilly (Hilly) (Flat) (Level)

(4) Purpose of Well: Domestic (Domestic Irrigation, Municipal, Industrial, Other)

Table with 3 columns: Description & Color of Materials, Thickness Feet, Depth Feet. Contains handwritten entries: clay, sand & gravel, gravel & clay, sand & gravel.


Information upon completion of well:

- (1) Diameter 2 inches.
(2) Total Depth 127 feet.
(3) Water Level 46 feet below top of ground.
(4) Cased to Bottom, Size 2.
(5) Screen: Size 1/4, Length 6 ft.
(6) Were any formations sealed against pollution? yes, no.

If YES depth of formation
Why

Drillers Remarks:

CODED

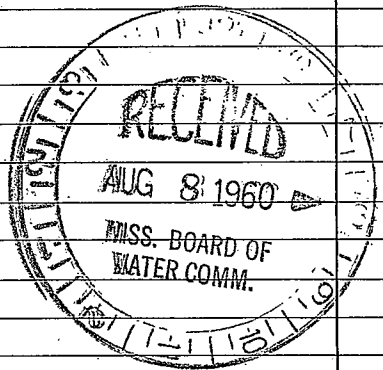

Well No.

(Use Back Side)

