

PIKE

MISSISSIPPI BOARD OF WATER COMMISSIONERS

D 20 CODED

9-6-60

WATER WELL DRILLERS LOG

D-303

Date: 9-6, 1960, Driller: Chester Reeves County Pike

(Name)

(1) Owner of Land: Sunoil Co. (Name) M.C. Comb Miss (Address)

(2) Location: 1/4, 1/4, Sec. 3 T3R1, 2 miles West of M.C. Comb (distance) (direction) (Nearest Town)

(3) Topography: Flat (Hilly) (Flat) (Level)

(4) Purpose of Well: Industrial (Domestic Irrigation) (Municipal, Industrial, Other)

Description & Color of Materials Sand, Clay, Red Clay, Shell, etc.	Thick- ness Feet	Depth Feet
Brown clay	20	20
sand & gravel	20	40
Gravel	5	45
sand & clay	20	65
white sand	26	91
Pea Gravel	9	100

Information upon completion of well:

(1) Diameter: 4 inches.

(2) Total Depth: 100 feet.

(3) Water Level: 25 feet below top of ground.

(4) Cased to Bottom, Size 4

(5) Screen: Size 3 3/4, Length 20'

(6) Were any formations sealed against pollution?


yes, no.

If YES depth of formation: 30 ft.

Why: 8" Cemented casing - surface protection -

Drillers Remarks:

CODED

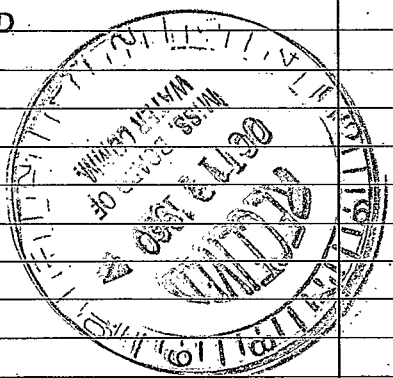

Well No.

(Use Back Side)

