

PIKE

D21 CODED

WATER WELL DRILLERS LOG

D-304

Date: 8-25-60, 1960, Driller: Chestnut Hayes, County: Pike

(Name)

(1) Owner of Land: Mr. G. F. Thomas  
(Name)  
McComb, Miss.  
(Address)

Description & Color of Materials Sand, Clay, Red Clay, Shell, etc.	Thick- ness Feet	Depth Feet
Red Clay	15	15
Sand & gravel	85	100

(2) Location: 1/4, 1/4, Sec. 11 T3.R7  
1 miles west of McComb  
(distance) (direction) (Nearest Town)

(3) Topography: Hilly  
(Hilly) (Flat) (Level)

(4) Purpose of Well: Domestic  
(Domestic Irrigation  
Municipal, Industrial, Other)

Information upon completion of well:

(1) Diameter: 7 inches.

(2) Total Depth: 100 feet.

(3) Water Level: 60 feet below top of ground.

(4) Cased to: Balltown Size 2"

(5) Screen: Size 1 1/2", Length 6'


(6) Were any formations sealed against pollution?

yes,  no.

If YES depth of formation

Why

Drillers Remarks:

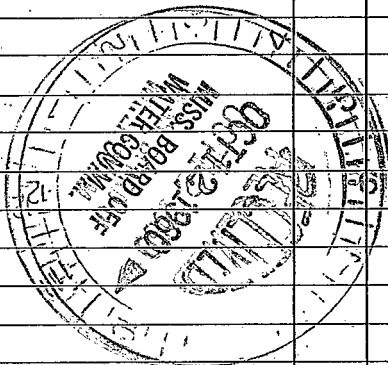

CODED

(Use Back Side)

Well No.

