

PIKE

MISSISSIPPI BOARD OF WATER COMMISSIONERS

D22 CODED  
10-4-60

WATER WELL DRILLERS LOG

CODED

-305

Date: 10-4, 1960, Driller: Chester Reeves County Pike

(Name)

- (1) Owner of Land: RAMSAY GUYTON  
(Name)  
RFD Summit  
(Address)
- (2) Location: Park Drive  
1/4, 1/4, Sec 5, 1/4 T 3R 7,  
2 miles west of Mt. Comb,  
(distance) (direction) (Nearest Town)
- (3) Topography: Level  
(Hilly) (Flat) (Level)
- (4) Purpose of Well: Domestic  
(Domestic Irrigation  
Municipal, Industrial, Other)

Description & Color of Materials Sand, Clay, Red Clay, Shell, etc.	Thick- ness Feet	Depth Feet
clay	22	22
Red sand	18	40
sand & gravel	72	112

Information upon completion of well:


- (1) Diameter 4 inches.
- (2) Total Depth 112 feet.
- (3) Water Level 73 feet below top of ground.
- (4) Cased to bottom, Size 4"
- (5) Screen: Size 3 3/4" length 5'
- (6) Were any formations sealed against pollution?  
yes,  no.

CODED

If YES depth of formation \_\_\_\_\_

Why \_\_\_\_\_

Drillers Remarks: \_\_\_\_\_

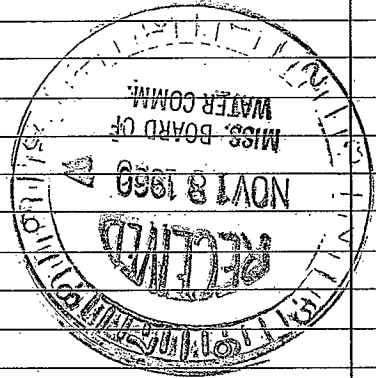

(Use Back Side)

Well No.

