

PIKE
D23 CODED
2-13-61

MISSISSIPPI BOARD OF WATER COMMISSIONERS

WATER WELL DRILLERS LOG

CODED

Date: 2-13, 1961, Driller: Chester Reeves County Pike
(Name)

(1) Owner of Land: Archie Niman
(Name)
RFD Summit
(Address)
INT. Park Drive Hwy 2
(2) Location: 1/4, 1/4 Sec. 3 T. 7
4 miles west of McComb
(distance) (direction) (Nearest Town)
(3) Topography: Hilly
(Hilly) (Flat) (Level)
(4) Purpose of Well: Domestic
(Domestic Irrigation
Municipal, Industrial, Other)

Description & Color of Materials Sand, Clay, Red Clay, Shell, etc.	Thick- ness Feet	Depth Feet
<u>Red Clay</u>	<u>18</u>	<u>18</u>
<u>Red sand</u>	<u>17</u>	<u>35</u>
<u>Big hard gravel</u>	<u>10</u>	<u>45</u>
<u>Red sand</u>	<u>15</u>	<u>60</u>
<u>Mixed colored chalk</u>	<u>25</u>	<u>85</u>
<u>small gravel & sand</u>	<u>13</u>	<u>98</u>


Information upon completion of well:

(1) Diameter 2 inches.
(2) Total Depth 98 feet.
(3) Water Level 82 feet below top of ground.
(4) Cased to bottom (Size 2")
(5) Screen: Size 1 1/4", Length 6'
(6) Were any formations sealed against pollution?
 yes, no.

If YES depth of formation 10' - Cemented
Why Required - G.U. Loan

Drillers Remarks:
New house - no
Previous well

CODED

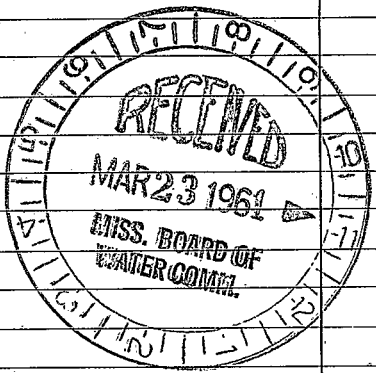

(Use Back Side)

Well No.

