

PIKE D 25 CODED WATER WELL DRILLERS LOG

Date: 5-1-, 1961, Driller: W. J. Fitzgerald County Pike
 (Name)
5-1-61

(1) Owner of Land: Country Club
 (Name)
Fern Wood MISS
 (Address)

(2) Location: SW 1/4, SE 1/4, Sec 36 T. 7 R. 3
1 miles SW of Fernwood
 (distance) (direction) (Nearest Town)

(3) Topography: Hilly
 (Hilly) (Flat) (Level)

(4) Purpose of Well:
 (Domestic Irrigation
 Municipal, Industrial, Other)

Description & Color of Materials Sand, Clay, Red Clay, Shell, etc.	Thick- ness Feet	Depth Feet
Top Soil & Clay	0	15
Red Sand	15	40
Gravel & Sand	40	55
Red Chalk	55	60
Coarse Sand & gravel	60	96
Rock	96	99
Chalk	99	105
Sand & Coarse Gravel	105	125
White Chalk	125	-

Information upon completion of well:

(1) Diameter 6 inches.

(2) Total Depth 96 feet.

(3) Water Level 60 feet below top of ground.

(4) Cased to 78, Size 6

(5) Screen: Size 3, Length 18'


(6) Were any formations sealed against pollution?
 _____ yes, no.

CODED

If YES depth of formation _____

Why _____

Drillers Remarks: _____

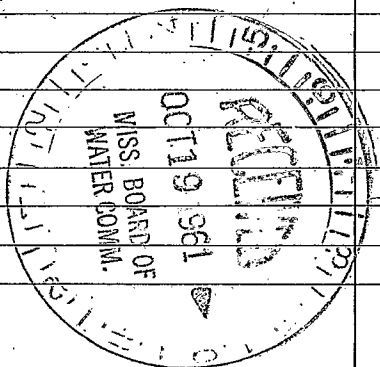

(Use Back Side)

Well No.

①