

PIKE

MISSISSIPPI BOARD OF WATER COMMISSIONERS

D26 CODED

6-7-61

WATER WELL DRILLERS LOG

Date: 6-7, 1961, Driller: Chester Revers County: Pike

(Name)

(1) Owner of Land:	Description & Color of Materials. Sand, Clay, Red Clay, Shell, etc.	Thick- ness Feet
Prescott Sherman (Name) McComb (Address)	clay red sand sand gravel	18 37
(2) Location: 1/4, 1/4, Sec. 3 T3 R7 2 miles west of McComb (distance) (direction) (Nearest Town)	clean sand & gravel	30 4
(3) Topography: Hilly (Hilly) (Flat) (Level)		9.3
(4) Purpose of Well: Domestic (Domestic Irrigation Municipal, Industrial, Other)		


Information upon completion of well:

- (1) Diameter 4 inches.
- (2) Total Depth 93 feet.
- (3) Water Level 60 feet below top of ground.
- (4) Cased to Bottom, Size 4
- (5) Screen: Size none, Length
- (6) Were any formations sealed against pollution?
yes, no.

CODED

If YES depth of formation
Why

Drillers Remarks: No Previous well at locations

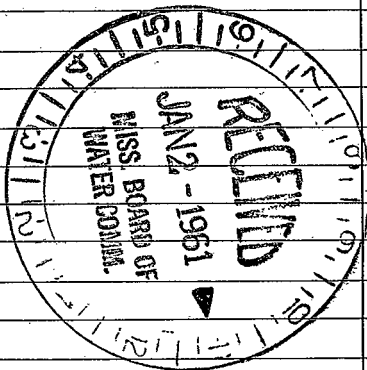

(Use Back Side)

