

PIKE CODED MISSISSIPPI BOARD OF WATER COMMISSIONERS

D 33 CODED

2-6-64 CODED

WATER WELL DRILLERS LOG

CODED

Date: 2-6, 1964, Driller: Chester Reeves County PIKE
(Name)

(1) Owner of Land: Phyllis Well Hooper
(Name)
RFD - Summit
(Address)

(2) Location: 1/4, 20 1/4, Sec. 24 T 3 R 7

4 miles west of McComb
(distance) (direction) (nearest town)

(3) Topography: Hilly
(Hilly) (Flat) (Level)

(4) Purpose of Well: Domestic
(Domestic Irrigation, Municipal, Industrial, Other)

Description & Color of Materials Sand, Clay, Red Clay, Shell, etc.	Thick- ness Feet	Dep- th Feet
<u>0-20 - clay</u>	<u>20</u>	<u>20</u>
<u>Red Sand & gravel</u>	<u>50</u>	<u>70</u>
<u>chalk & gravel</u>	<u>20</u>	<u>90</u>
<u>clean gravel</u>	<u>23</u>	<u>113</u>

CODED

Information upon completion of well:

(1) Diameter 4 inches.

(2) Total Depth 113 feet.

(3) Water Level 68 feet below top of ground.

(4) Cased to bottom, Size 4

(5) Screen: Size F, Length 10 ft.


(6) Were any formations sealed against pollution?
no

If YES depth of formation _____

Why _____

Drillers Remarks: old well
Bad

CODED

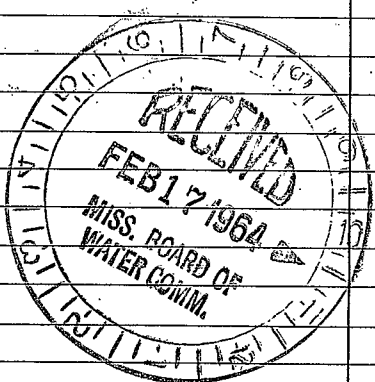

CHESTER REEVES WELL & PUMP CO.
P. O. BOX 71 -- PHONE 684-1451
MCCOMB, MISS.

Well No.

(Use Back Side)

100

100

