

PIKE
 D38 CODED
 3-17-66

MISSISSIPPI BOARD OF WATER COMMISSIONERS

WATER WELL DRILLERS LOG

Date: 3-17, 1966, Driller: Chester Reeves County Pike
 (When well drilled) (Name) (Where well is located)

(1) Owner of Land:	Description & Color of Materials Sand, Clay, Red Clay, Shell, etc.	Thick- ness Feet	Depth Feet
W.E. Middleton Rt-3, M. Tomb (Name) (Address)	Red clay Red sand almost pure gravel	20 30	20 50
(2) Location: 1/4, 1/4, Sec 27 T3 R7 5 miles west of Tomb (distance) (direction) (Nearest Town)	medium sized pebbles	15 15	65 80
(3) Topography: Hilly - (Hilly) (Flat) (Level)	Coarse sand & Red gravel	17	97
(4) Purpose of Well: Domestic (Domestic Irrigation Municipal, Industrial, Other)			


Information upon completion of well:

- (1) Diameter 4 inches.
- (2) Total Depth 97 feet.
- (3) Water Level 70 feet below top of ground.
- (4) Cased to Bottom Size 4"
- (5) Screen: Size 4", Length 6"
- (6) Were any formations sealed against pollution?
 yes, no.

If YES depth of formation _____

Why _____

Drillers Remarks: red well Bal
 Yield in gpm: Pumped 10
 Size pump: 3/4 HP 1 1/2 ft
 Type power: Electric

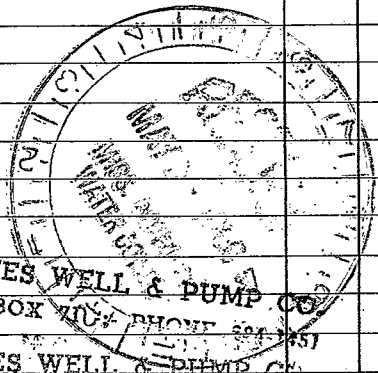

BEEVES WELL & PUMP CO.
 P. O. BOX 711 PHONE 684-1451
 BEEVES WELL & PUMP CO.
 P. O. BOX 71 -- PHONE 684-1451
 McCOMB, MISS.

~~100~~

7

4

2