

Pike
 D40 CODED
 6-66 CODED

MISSISSIPPI
 BOARD OF WATER COMMISSIONERS
 416 North State Street
 Jackson, Mississippi 39201

WATER WELL DRILLERS LOG

6-13 1966 Fitzgerald Water Well Serv Pike
 date well completed firm name county well located

LANDOWNER: HIV McPhee
Rt 3 Summit Miss
 (mailing address)

description of formations encountered	from	to
Top Soil & Clay	0	15
Red Sand		35
Sand & gravel		60
Soupy Sand		75
White sand & gravel		95
White Chalk		95

WELL LOCATION:
 sec 7 T 3 N 7 E
6 miles W NW of McPhee
 (distance) (direction) (nearest town)


WELL PURPOSE: home
 (home, irrigation, municipal, industrial)

- WELL COMPLETION DATA:
- (1) diameter (inches) 4
 - (2) total depth (feet) 194
 - (3) static water level (feet) 80 below above top of ground.
 - (4) casing plastic 86 (material) (depth)
4 (size) If telescope see back.
 - (5) screen 8 (length) 86 (depth to top)
4 1/2 (size) plastic (material)
 - (6) pump 1 Jet 8 (HP) (yield gpm)
Elec (type power)
 - (7) electric log No (yes or no)

CODED


(organization running log)
 (8) how well bottom plugged Wood Peg

DRILLERS REMARKS:

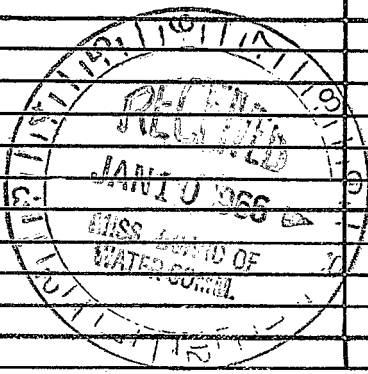

If well telescopes please sketch and show depths.

GROUND LEVEL

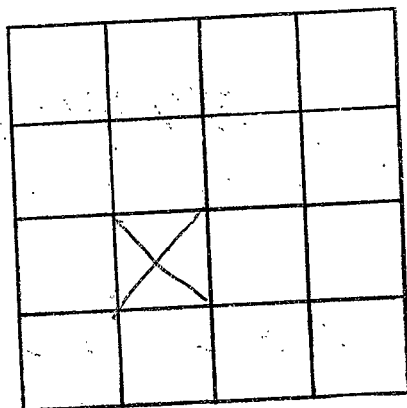

SECTION 5

Please indicate well location X.

ADDITIONAL INFORMATION

If more than one screen, show locations of each on sketch.