

Pike
DA
7-3-66

MISSISSIPPI BOARD OF WATER COMMISSIONERS

CODED

WATER WELL DRILLERS LOG

Date: 3 July, 1966, Driller: J. T. Compton Em County Pike
(Name)

(1) Owner of Land: Daniel Quinn
(Name)
McComb, Miss
(Address)

(2) Location: Center $\frac{1}{4}$, Sec. 22 T3 R7,
3 miles west of McComb
(distance) (direction) (Nearest Town)

(3) Topography: (Hilly) (Flat) (Level)

(4) Purpose of Well: Pow. W.
(Domestic Irrigation
Municipal, Industrial, Other)

Description & Color of Materials Sand, Clay, Red Clay, Shell, etc.	Thick- ness Feet	Depth Feet
<u>Clay</u>	<u>70</u>	
<u>Sand & Rock</u>	<u>20</u>	<u>90</u>
<u>Chalk</u>	<u>40</u>	<u>130</u>
<u>Sand & Rock</u>	<u>30</u>	<u>160</u>
<u>Chalk</u>	<u>60</u>	<u>220</u>
<u>Sand</u>	<u>40</u>	<u>260</u>

Information upon completion of well:

(1) Diameter 4" inches.

(2) Total Depth 260 feet.

(3) Water Level 90 feet below top of ground.

(4) Cased to 8' 170ft, Size 4" 260ft.


(5) Screen: Size 2", Length 10'.

(6) Were any formations sealed against pollution?
 yes, no.

CODED

If YES depth of formation 160ft
Why Salt Water

Drillers Remarks:
Salt Water Sealed off
in 160ft water sand

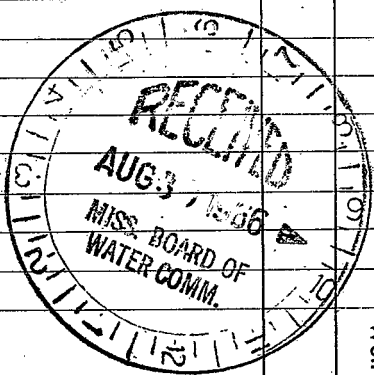

Well No.

(Use Back Side)

