

Pike
 D42
 7-66

MISSISSIPPI
 BOARD OF WATER COMMISSIONERS
 416 North State Street
 Jackson, Mississippi 39201

WATER WELL DRILLERS LOG

7-22 1966 66 Fitzgerald Water Well Serv Pike
 date well completed firm name county well located

LANDOWNER: W Newman
R S McComb Griss
 (mailing address)

| description of formations encountered | from | to |
|---------------------------------------|------|-----|
| Red Clay | 0 | 20 |
| Red Sand | 45 | 65 |
| Sand & gravel | 70 | 85 |
| Coarse Sand & gravel | 35 | 120 |

WELL LOCATION:
 sec 21 T 3 N 4 E
5 miles W SW of McComb
 (distance) (direction) (nearest town)

WELL PURPOSE: house
 (home, irrigation, municipal, industrial)


- WELL COMPLETION DATA:
- (1) diameter (inches) 4
 - (2) total depth (feet) 115
 - (3) static water level (feet) 80 below above top of ground.
 - (4) casing plastic 107
 (material) (depth)
4 if telescope see back.
 (size)
 - (5) screen 8 107
 (length) (depth to top)
4 plastic
 (size) (material)
 - (6) pump 1/2 Sub 17
 (HP) (yield gpm)
310 c
 (type power)
 - (7) electric log No
 (yes or no)
 (organization running log)
 - (8) how well bottom plugged hard pay

CODED

DRILLERS REMARKS:

If well telescopes please sketch and show depths.

GROUND LEVEL

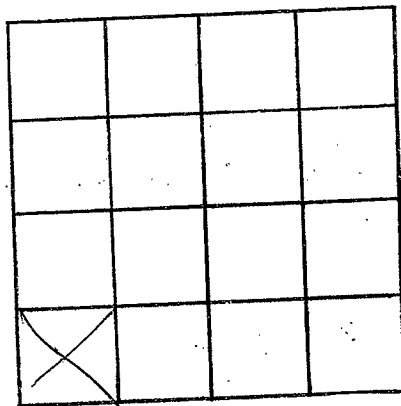

SECTION 2/

Please indicate well location X.

ADDITIONAL INFORMATION

If more than one screen, show locations of each on sketch.