

PIKE
D43 CODED

7-22-66 MISSISSIPPI BOARD OF WATER COMMISSIONERS

WATER WELL DRILLERS LOG

Date: July 22, 1966, Driller: W. Massey County Pike
(When well drilled) (Name) (Where well is located)

1) Owner of Land: Dob Jackson
(Name)
McComb, MS
(Address)

2) Location: 1/4, 1/4, Sec. 21 T3R7
5 miles W, of McComb
(distance) (direction) (Nearest Town)

3) Topography: (Hilly) (Flat) (Level)

4) Purpose of Well: (Domestic Irrigation) (Municipal, Industrial, Other)

Description & Color of Materials Sand, Clay, Red Clay, Shell, etc.	Thick- ness Feet	Depth Feet
<u>Red clay</u>	<u>0</u>	<u>20</u>
<u>Red sand</u>	<u>20</u>	<u>65</u>
<u>Dark gravel</u>	<u>65</u>	<u>85</u>
<u>White coarse sand & gravel</u>	<u>85</u>	<u>120</u>

Information upon completion of well:

1) Diameter 4 inches.

2) Total Depth 125 feet.

3) Water Level _____ feet below top of ground.

4) Cased to 100, Size _____.

5) Screen: Size 4", Length 8'.

6) Were any formations sealed against pollution?
_____ yes, no.

If YES depth of formation _____

Why _____


Drillers Remarks: _____

Yield in gpm: _____

Size pump: _____

Type power: _____

CODED

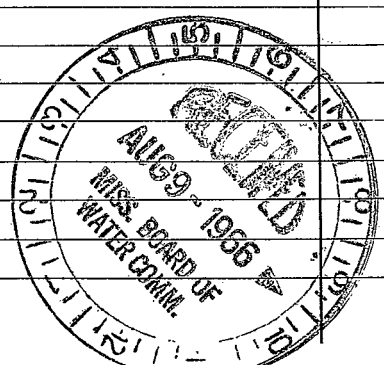

Mail this copy to Board of Water Commissioners 429 Miss. St. Jackson, Miss.

