

Pike

044 CODED

10-66 MISSISSIPPI BOARD OF WATER COMMISSIONERS

WATER WELL DRILLERS LOG

Date: 10-6, 1966, Driller: Nic Fitzgerald County Pike
 (When well drilled) (Name) (Where well is located)

1) Owner of Land: Dennis J. Jacobs
 (Name)
M C Colmb
 (Address)

2) Location: NE 1/4, SW 1/4, Sec. 10 T. 3 R. 7
1 miles W of M Colmb
 (distance) (direction) (Nearest Town)

3) Topography: (Hilly) (Flat) (Level)

4) Purpose of Well: Domestic
 (Domestic Irrigation
 Municipal, Industrial, Other)

Description & Color of Materials Sand, Clay, Red Clay, Shell, etc.	Thick- ness Feet	Depth Feet
		<u>0</u>
<u>Red clay</u>	<u>20</u>	<u>20</u>
<u>Red sand</u>	<u>56</u>	<u>76</u>
<u>Coarse sand & gravel</u>	<u>14</u>	<u>90</u>
<u>Red silty sand</u>	<u>9</u>	<u>99</u>
<u>Coarse sand & gravel</u>	<u>12</u>	<u>111</u>

Information upon completion of well:

1) Diameter 4 inches.

2) Total Depth 111 feet.

3) Water Level 85' feet below top of ground.

4) Cased to 103, Size 4"

5) Screen: Size 4", Length 8'

6) Were any formations sealed against pollution?
no


YES depth of formation _____
 why _____

Drillers Remarks: _____

Yield in gpm: 35 gpm

Size pump: 1/2 HP

Type power: elec

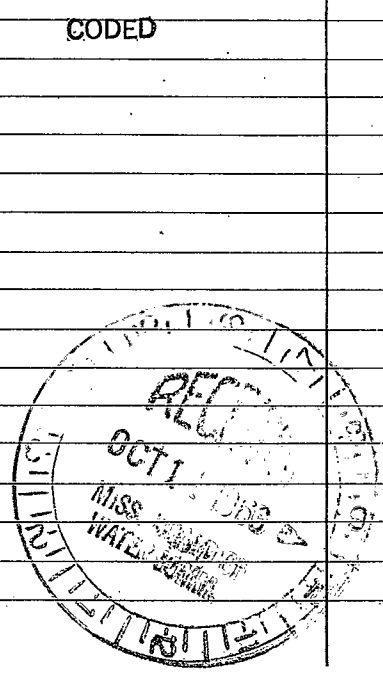

File this copy to Board of Water Commissioners 429 Miss. St. Jackson, Miss.

[The page contains extremely faint and illegible text, likely bleed-through from the reverse side of the document. No specific words or phrases can be discerned.]