

Pike
247
11-66

CODED
CODED

MISSISSIPPI BOARD OF WATER COMMISSIONERS

WATER WELL DRILLERS LOG

Date: 11-11, 1966, Driller: Eric Fitzgerald County Pike
 (When well drilled) (Name) (Where well is located)

1) Owner of Land: Howard Varnadore
 (Name)
Rt 3 - McComb
 (Address)
 2) Location: SE 1/4, SW 1/4, Sec. 34 T. 3 R. 7
6 miles NW of Magnolia
 (distance) (direction) (Nearest Town)
 3) Topography: X
 (Hilly) (Flat) (Level)
 4) Purpose of Well: Domestic
 (Domestic Irrigation
 Municipal, Industrial, Other)


Description & Color of Materials Sand, Clay, Red Clay, Shell, etc.	Thick- ness Feet	Depth Feet
		0
Red clay	30	30
Red sand	45	75
Fine gravel	10	85
Coarse sand & gravel	11	96

Information upon completion of well:

1) Diameter 4 inches.
 2) Total Depth 96 feet.
 3) Water Level 60 feet below top of ground.
 4) Cased to 88, Size 4"
 5) Screen: Size 4", Length 8'
 6) Were any formations sealed against pollution?
 _____ yes, X no.
 YES depth of formation _____

 Driller's Remarks: _____
 Yield in gpm: 35 gpm
 Size pump: Open
 Type power: Electric

CODED

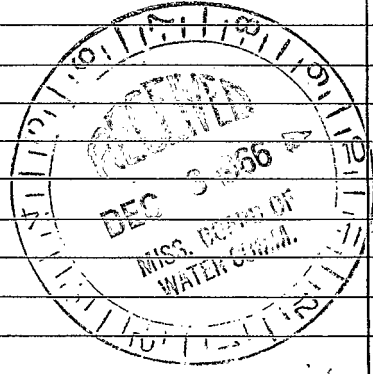

Send this copy to Board of Water Commissioners 429 Miss. St. Jackson, Miss.

