

Pike CODED
 D49 CODED
 1-67

MISSISSIPPI
 BOARD OF WATER COMMISSIONERS
 416 North State Street
 Jackson, Mississippi 39201

WATER WELL DRILLERS LOG

1-9 1967 Fitzgerald Water Wells pike
 date well completed firm name county well located

LANDOWNER: Mrs E. B. Browning

description of formations encountered from to

R3 McComb Miss
 (mailing address)

Top Soil - Clay	0	15
Red Sand	55	70
Sand + gravel	20	90
Red Chalk	7	97
White Fine Sand	9	105
sand + gravel	11	116


WELL LOCATION:
 sec 28 T 3 N 2 R 7 E
6 miles SW of McComb
 (distance) (direction) (nearest town)

WELL PURPOSE:
 (home, irrigation, municipal, industrial)

WELL COMPLETION DATA:

- (1) diameter (inches) 4
- (2) total depth (feet) 116
- (3) static water level (feet) 90 below above top of ground.
- (4) casing plastic, 108
 (material) (depth)
- 4 if telescope see back.
 (size)
- (5) screen 8', 108
 (length) (depth to top)
- 4, plastic
 (size) (material)
- (6) pump Sub 1/2 10
 (HP) (yield gpm)
- 3hp
 (type power)
- (7) electric log No
 (yes or no)
- (organization running log)
- (8) how well bottom plugged fluid log

CODED

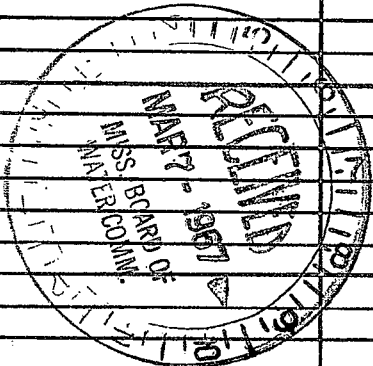

DRILLERS REMARKS:

If well telescopes please sketch and show depths.

GROUND LEVEL

X			

SECTION 28

Please indicate well location X.

ADDITIONAL INFORMATION

If more than one screen,
show locations of each on sketch.