

Pike CODED
 D50
 2-67 CODED

MISSISSIPPI
 BOARD OF WATER COMMISSIONERS
 416 North State Street
 Jackson, Mississippi 39201

WATER WELL DRILLERS LOG

Feb 3 1967 67 REEVES WELL & PUMP Pike
 date well completed firm name county well located

LANDOWNER: EDGAR MAGEE
 Rt-3
 M.C. Comb.
 (mailing address)

description of formations encountered	from	to
top clay sand	0	12
red sand & gravel	12	50
gravel	50	60
chalk & gravel	60	67
sea gravel & sand	67	82

WELL LOCATION:
 sec 24 T 3 N R 7 E
 1 miles S of M.C. Comb.
 (distance) (direction) (nearest town)

WELL PURPOSE: Home
 (home, irrigation, municipal, industrial)

WELL COMPLETION DATA:


- (1) diameter (inches) 4
- (2) total depth (feet) 82
- (3) static water level (feet) 58 below top of ground.
- (4) casing Plastic bottom (material) (depth)
 4" (size) if telescope see back.
- (5) screen 6' 76' (length) (depth to top)
 4" Plastic (size) (material)
- (6) pump 1-hp 10 (HP) (yield gpm)
 Electric (type power)
- (7) electric log No (yes or no)

(organization running log)

(8) how well bottom plugged Dry wooden

DRILLERS REMARKS:
 New House

CODED

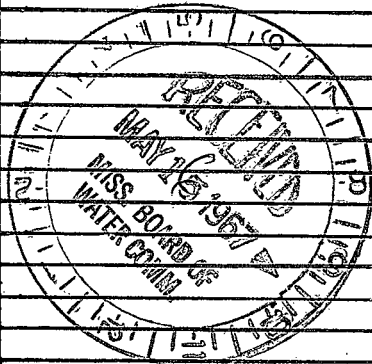

If well telescopes please sketch and show depths.

GROUND LEVEL

		f	

SECTION 24

Please indicate well location X.

ADDITIONAL INFORMATION

If more than one screen,
show locations of each on sketch.