

Pike CODED

D51 CODED

3-67

MISSISSIPPI BOARD OF WATER COMMISSIONERS
416 North State Street
Jackson, Mississippi 39201

WATER WELL DRILLERS LOG

Mar 7
date well completed

19 67
Fitzgibbon Well Drives
firm name

Pike
county well located

LANDOWNER: W. W. Williams

Description of formations encountered

from to

Park Drive - McComb
(mailing address)

Red Clay	3	15
Red Silty Sand	15	45
Red Shale	45	65
Red Sand & Shale	65	95
Coarse Shale	95	109

WELL LOCATION:

sec 21 T 3 N R 7 E
2 miles W of McComb
(distance) (direction) (nearest town)


WELL PURPOSE: HOME
(home, irrigation, municipal, industrial)

WELL COMPLETION DATA:

- (1) diameter (inches) 4
- (2) total depth (feet) 109
- (3) static water level (feet) 80 below top of ground.
- (4) casing Plastic 101 (material), (depth)
24" (size) if telescope see back.
- (5) screen 8' 101' (length), (depth to top)
4" Plastic (size), (material)
- (6) pump 3/4 15 (HP), (yield gpm)
Electric (type power)
- (7) electric log No (yes or no)
(organization running log)
- (8) how well bottom plugged Wood Peg

CODED

DRILLERS REMARKS:

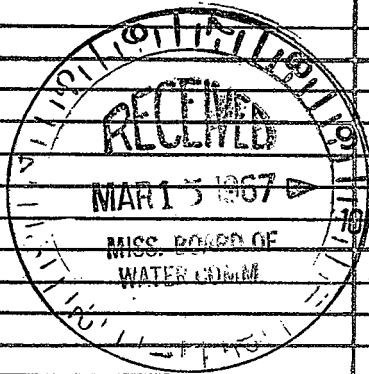

If well telescopes please sketch and show depths.

GROUND LEVEL

	X		

SECTION 21

Please indicate well location X.

ADDITIONAL INFORMATION

If more than one screen, show locations of each on sketch.