

CODED

Pike

D52

CODED

4-67

MISSISSIPPI
 BOARD OF WATER COMMISSIONERS
 416 North State Street
 Jackson, Mississippi 39201

WATER WELL DRILLERS LOG

April 26 1967 REEVES WELL & PUMP PIKE
 date well completed firm name county well located

LANDOWNER: WELL DAVIS

description of formations encountered

from to

Rt-3
McLamb
 (mailing address)

Red clay 0 20
Red sand 20 52
white sand 52 63

WELL LOCATION:

sec. 24 T3 N R 7 E
1 1/2 miles S of McLamb
 (distance) (direction) (nearest town)

WELL PURPOSE: Home
 (home, irrigation, municipal, industrial)

WELL COMPLETION DATA:

- (1) diameter (inches) 4
- (2) total depth (feet) 63
- (3) static water level (feet) 35 below above top of ground.

(4) casing Plastic Bottom
 (material) (depth)

CODED

4 if telescope see back.
 (size)

(5) screen 6' 57'
 (length) (depth to top)

4" Plastic
 (size) (material)

(6) pump 6
 (HP) (yield gpm)


Electric
 (type power)

(7) electric log NO
 (yes or no)

(organization running log)


(8) how well bottom plugged woody

DRILLERS REMARKS:

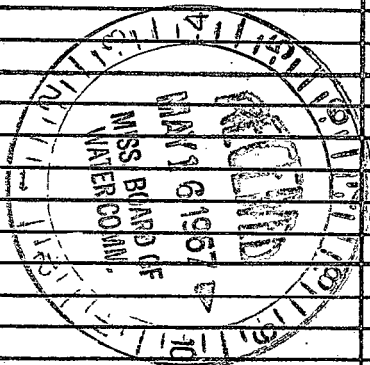

If well telescopes please sketch and show depths.

GROUND LEVEL

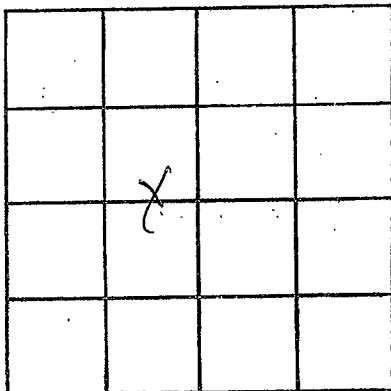

SECTION 24

Please indicate well location X.

ADDITIONAL INFORMATION

If more than one screen, show locations of each on sketch.