

CODED

Pike

053

5-67

CODED

MISSISSIPPI
 BOARD OF WATER COMMISSIONERS
 416 North State Street
 Jackson, Mississippi 39201

WATER WELL DRILLERS LOG

May 11
date well completed

67 REEVES WELL Pump
firm name

Pike
county well located

LANDOWNER: J.R. Daniels Jr.
 P.O. Box 3
 Mr. Lamb
 (mailing address)

description of formations encountered	from	to
top clay & gravel	0	12
red sand & gravel	12	50
gravel	50	60
chalk & gravel	60	72
pea gravel sand	72	87

WELL LOCATION:
 sec 24 T 3 N R 7 E
1 1/2 miles S. of Mr. Lamb
 (distance) (direction) (nearest town)

WELL PURPOSE: Home
 (home, irrigation, municipal, industrial)

WELL COMPLETION DATA:


- (1) diameter (inches) 4"
- (2) total depth (feet) 87
- (3) static water level (feet) 58 below above top of ground.
- (4) casing plastic bottom
(material) (depth)
- 4 if telescope see back.
(size)
- (5) screen 6' 81'
(length) (depth to top)
- 4" plastic
(size) (material)
- (6) pump 6
(HP) (yield gpm)
- Electric
(type power)
- (7) electric log no
(yes or no)

CODED

(organization running log)


(8) how well bottom plugged woolly

DRILLERS REMARKS:

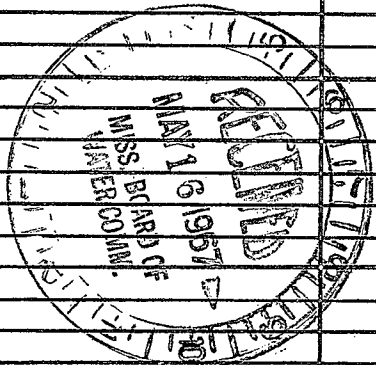

If well telescopes please sketch and show depths.

GROUND LEVEL

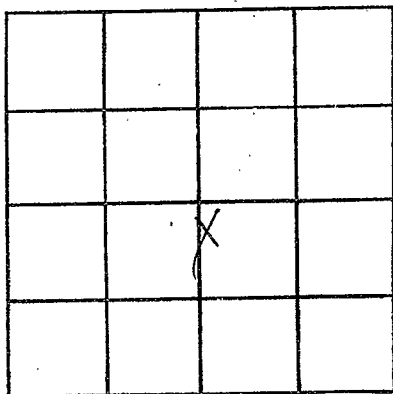

SECTION 24

Please indicate well location X.

ADDITIONAL INFORMATION

If more than one screen, show locations of each on sketch.