

CODED

MISSISSIPPI
BOARD OF WATER COMMISSIONERS
416 North State Street
Jackson, Mississippi 39201

WATER WELL DRILLERS LOG

Pike CODED
D54
5-67

MAY 19 1967 FITZGERALD WELL SERV PIKE
date well completed firm name county well located

LANDOWNER: GROUP CAMP

PARKY QUINN STATE PARK

ROUTE, McComb, Miss
(mailing address)

WELL LOCATION:

sec. 31 T. 3 N. R. 7 E
4 miles SW of McComb
(distance) (direction) (nearest town)

WELL PURPOSE: CAMPING AREA
(home, irrigation, municipal, industrial)

WELL COMPLETION DATA:

- (1) diameter (inches) 4"
- (2) total depth (feet) 93'
- (3) static water level (feet) 15' below top of ground.
- (4) casing PLASTIC 83' (material) (depth)
4" (size) if telescope see back.
- (5) screen 10' 83' (length) (depth to top)
4" (size) PLASTIC (material)
- (6) pump 3 (HP) 429 gpm (yield gpm)
ELEC (type power)
- (7) electric log NO (yes or no)
(organization running log)
- (8) how well bottom plugged sand plug


description of formations encountered

from to

Red clay	0	15
Coarse sand & gravel	15	40
White chert	40	50
Coarse sand & gravel	50	93


CODED

DRILLERS REMARKS:

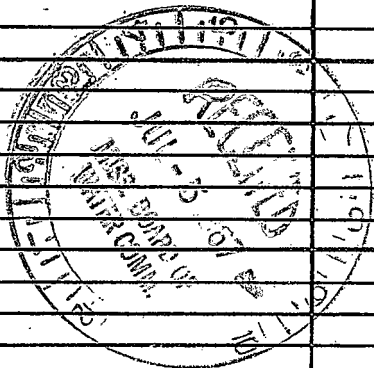

If well telescopes please sketch and show depths.

GROUND LEVEL

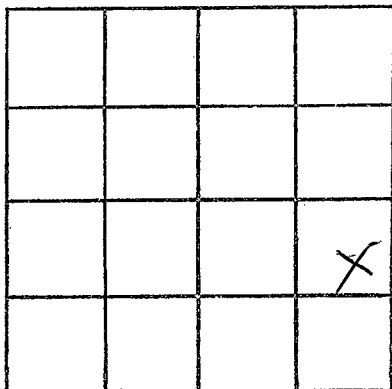

SECTION 31

Please indicate well location X.

ADDITIONAL INFORMATION

If more than one screen, show locations of each on sketch.