

CODED

PIKE

D55

CODED

6-67

MISSISSIPPI BOARD OF WATER COMMISSIONERS

416 North State Street

Jackson, Mississippi 39201

WATER WELL DRILLERS LOG

June 6 - 1967

date well completed

67-1 top gravel Water Well

firm name

Pike

county well located

LANDOWNER:

Porter G. Gresham  
Rt 3, Malcomb

Description of formations encountered

from

to

(mailing address)

WELL LOCATION:

sec 31 T. 3 N. R. 7 E. S. W.  
4 miles SW of Malcomb  
(distance) (direction) (nearest town)

WELL PURPOSE:

Com. Irrigation  
(home, irrigation, municipal, industrial)

WELL COMPLETION DATA:


- (1) diameter (inches) 6
- (2) total depth (feet) 232
- (3) static water level (feet) 80 below above top of ground.
- (4) casing Iron 180  
(material) (depth)  
6 + 21' 4" galv.  
(size) if telescope see back.
- (5) screen 20 20  
(length) (depth to top)  
4 stainless  
(size) (material)
- (6) pump 7 1/2 120  
(HP) (yield gpm)  
Elec  
(type power)
- (7) electric log No  
(yes or no)

CODED

(organization running log)


(8) how well bottom plugged Wood Peg -

DRILLERS REMARKS:

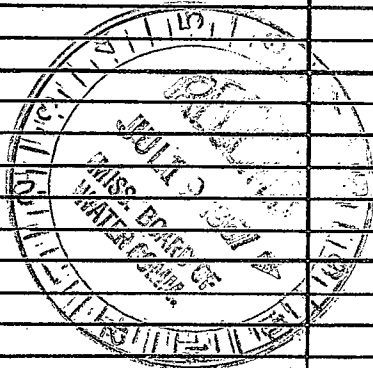

If well telescopes please sketch and show depths.

GROUND LEVEL

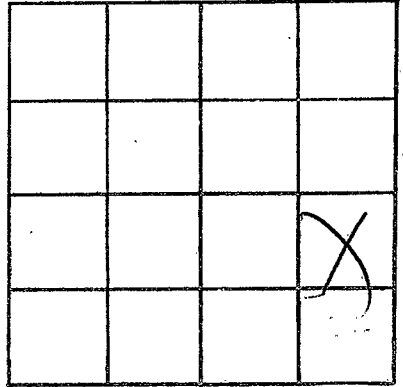

SECTION

31

Please indicate well location X.

ADDITIONAL INFORMATION

If more than one screen, show locations of each on sketch.