

Pike CODED
 D56 CODED
 6-67

MISSISSIPPI
 BOARD OF WATER COMMISSIONERS
 416 North State Street
 Jackson, Mississippi 39201

WATER WELL DRILLERS LOG

June 9 1967 Revere Well Drilling Co. Pike
 date well completed firm name county well located

LANDOWNER: Shylan
Vanado -
McLamb, Miss
 (mailing address)

description of formations encountered	from	to
Red sand	0	15
Red sand gravelly	15	25
Gravel	25	40
Red sandy clay	40	65
Small gravel & sand	65	75

WELL LOCATION:
 sec 10 T 3 N R. 7 E
1 miles West McLamb
 (distance) (direction) (nearest town)


WELL PURPOSE: Domestic
 (home, irrigation, municipal, industrial)

WELL COMPLETION DATA:

- (1) diameter (inches) 4"
- (2) total depth (feet) 73 ft
- (3) static water level (feet) 37 below above top of ground.
- (4) casing Plastic Bottom
 (material) (depth)
- _____ if telescope see back.
 (size)
- (5) screen 6' 67
 (length) (depth to top)
4" Plastic
 (size) (material)
- (6) pump 1/2 hp 12
 (HP) (yield gpm)
Slect
 (type power)
- (7) electric log NO
 (yes or no)
- _____ (organization running log)
- (8) how well bottom plugged woody
plugs

DRILLERS REMARKS:
New house.

CODED

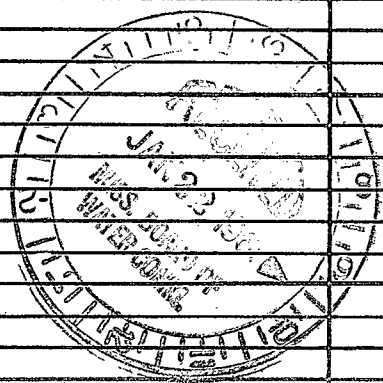

If well telescopes please sketch and show depths.

GROUND LEVEL

		X	

SECTION 10

Please indicate well location X.

ADDITIONAL INFORMATION

If more than one screen, show locations of each on sketch.