

PIKE CODED
 D57 CODED
 7-67

MISSISSIPPI
 BOARD OF WATER COMMISSIONERS
 416 North State Street
 Jackson, Mississippi 39201

WATER WELL DRILLERS LOG

7-6 date well completed
 J. Fitzgerald firm name
 Pike county well located

LANDOWNER: James J. ...
RT 4 Summit Miss
 (mailing address)


description of formations encountered	from	to
<u>Topsoil / clay</u>	<u>0</u>	<u>7</u>
<u>Red shale</u>	<u>7</u>	<u>27</u>
<u>Red sand</u>	<u>27</u>	<u>60</u>
<u>Sand gravel</u>	<u>60</u>	<u>80</u>
<u>Sand gravel</u>	<u>80</u>	<u>96</u>

WELL LOCATION:
 sec. 2 T. 3 N. R. 7 E.
4 miles W of W. ...
 (distance) (direction) (nearest town)

WELL PURPOSE: home
 (home, irrigation, municipal, industrial)

- WELL COMPLETION DATA:
- (1) diameter (inches) 4
 - (2) total depth (feet) 96
 - (3) static water level (feet) 80 below above top of ground.
 - (4) casing plastic 90
 (material) (depth)
 - 4 if telescope see back.
 (size)
 - (5) screen 6 90
 (length) (depth to top)
 - 4 plastic
 (size) (material)
 - (6) pump 1/2 (HP) ... (yield gpm)
Electric (type power)
 - (7) electric log ... (yes or no)
 (organization running log)
 - (8) how well bottom plugged ...


CODED

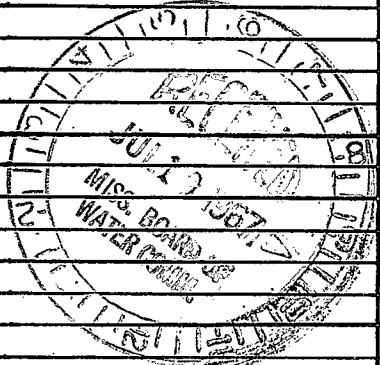

DRILLERS REMARKS:

If well telescopes please sketch and show depths.

GROUND LEVEL

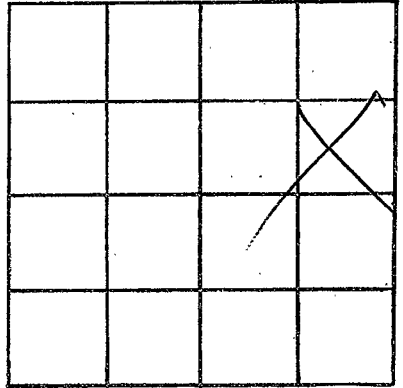

SECTION 2

Please indicate well location X.

ADDITIONAL INFORMATION

If more than one screen, show locations of each on sketch.