

CODED

PIKE
D58
7-67 CODED

MISSISSIPPI
BOARD OF WATER COMMISSIONERS
416 North State Street
Jackson, Mississippi 39201

WATER WELL DRILLERS LOG

7-19 1967 Fitzgerald W. Well Wks Pike
date well completed firm name county well located

LANDOWNER: John Morgan

description of formations encountered

from to

Fern Wood, Miss
(mailing address)

Top soil & clay 0 10
Dirty sand 10 30
Sand & gravel 30 40
Chalk 40

WELL LOCATION:


sec 36 T 3 N R 7 E
lines 11^S Fern Wood^W
(distance) miles (direction) of (nearest town)

WELL PURPOSE: home
(home, irrigation, municipal, industrial)

WELL COMPLETION DATA:

- (1) diameter (inches) 4
- (2) total depth (feet) 39
- (3) static water level (feet) 20 below top of ground.
- (4) casing plastic 33
(material) (depth)
- 4 if telescope see back.
(size)
- (5) screen 61, 33
(length) (depth to top)
- 4, plastic
(size) (material)
- (6) pump
(HP) (yield gpm)
- (type power)
- (7) electric log no
(yes or no)
- (organization running log)
- (8) how well bottom plugged Wood Peg


CODED

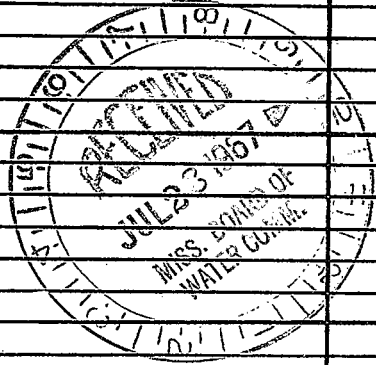

DRILLERS REMARKS:

If well telescopes please sketch and show depths.

GROUND LEVEL

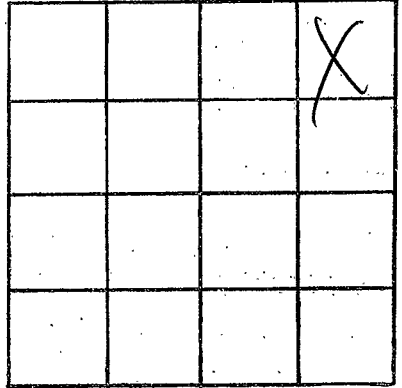

SECTION 86

Please indicate well location X.

ADDITIONAL INFORMATION

A series of horizontal lines for writing additional information.

If more than one screen, show locations of each on sketch.