

CODED

Pike

D59

8-67

CODED

MISSISSIPPI BOARD OF WATER COMMISSIONERS  
416 North State Street  
Jackson, Mississippi 39201

WATER WELL DRILLERS LOG

Aug 4 1967 Revere Well Drillers Pike  
date well completed firm name county well located

LANDOWNER: Emma Lewis  
McDaniel  
Fearwood -  
(mailing address)

description of formations encountered	from	to
Red clay gravel	0	12
Red sandy gravel	12	40
sand & gravel	40	55

WELL LOCATION:  
sec 36 T3 N R 7 E  
in miles Fearwood  
(distance) (direction) (nearest town)

WELL PURPOSE: Home  
(home, irrigation, municipal, industrial)


WELL COMPLETION DATA:

- (1) diameter (inches) 4 1/2
- (2) total depth (feet) 55
- (3) static water level (feet)   
 top of ground. below  
above
- (4) casing Plastic bottom  
(material) (depth)
- (5) screen 6' 49'  
(length) (depth to top)  
4" Plastic  
(size) (material)
- (6) pump 1/2 HP  
(type power) (yield gpm)
- (7) electric log No  
(yes or no)

CODED


(organization running log)  
(8) how well bottom plugged wooden plugs

DRILLERS REMARKS:  
old well had

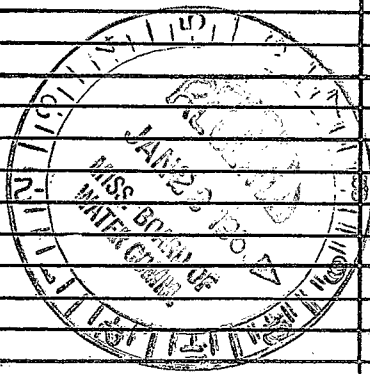

If well telescopes please sketch and show depths.

GROUND LEVEL

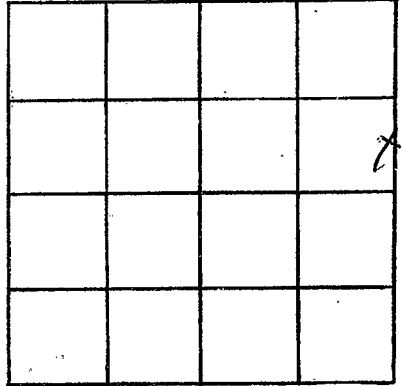

SECTION 36

Please indicate well location X.

ADDITIONAL INFORMATION

A series of horizontal lines for recording additional information.

If more than one screen, show locations of each on sketch.