

CODED

Pike

D60

CODED

8-67

MISSISSIPPI  
 BOARD OF WATER COMMISSIONERS  
 416 North State Street  
 Jackson, Mississippi 39201

WATER WELL DRILLERS LOG

Aug 14 1967 Fitzgerald Well Drives Pike  
 date well completed firm name county well located

LANDOWNER: C.W. Touchstone

description of formations encountered

from

to

Enterprise Rd

Red clay & sand

0 25

Rt 3, Summit, Miss  
(mailing address)

Coarse sand & gravel 25 54

WELL LOCATION:


sec. 7 T. 3 N. R. 7 E.  
3 miles W of McComb  
 (distance) (direction) (nearest town)

WELL PURPOSE: Home  
(home, irrigation, municipal, industrial)

WELL COMPLETION DATA:

- (1) diameter (inches) 4
- (2) total depth (feet) 54
- (3) static water level (feet) 35 below above top of ground.
- (4) casing plastic, 48,  
(material) (depth)  
4" If telescope see back.  
(size)
- (5) screen 6', 48  
(length) (depth to top)  
4", plastic  
(size) (material)
- (6) pump 1/2 12  
(HP) (yield gpm)  
Electric  
(type power)
- (7) electric log no  
(yes or no)  
no  
(organization running log)
- (8) how well bottom plugged wood peg


CODED

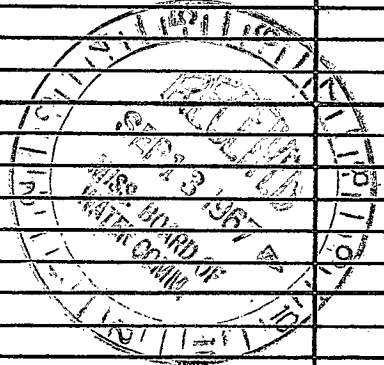

DRILLERS REMARKS:

If well telescopes please sketch and show depths.

GROUND LEVEL

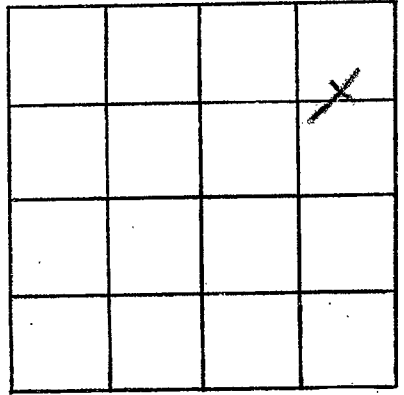

SECTION 7

Please indicate well location X.

ADDITIONAL INFORMATION

If more than one screen, show locations of each on sketch.