

MISSISSIPPI
BOARD OF WATER COMMISSIONERS
416 North State Street
Jackson, Mississippi 39201

WATER WELL DRILLERS LOG

PK CODED
D61
9-67 CODED

9-13 date well completed 1969 firm name Fitzgerald Water Well Pipe county well located

LANDOWNER: # F. Summfield

Rt 3 Summit

(mailing address)

WELL LOCATION:

sec. 4 T~~3~~ N~~2~~ R 9 E
S W of McComb
(distance) (direction) (nearest town)

WELL PURPOSE: house
(home, irrigation, municipal, industrial)

WELL COMPLETION DATA:

- (1) diameter (inches) 4
- (2) total depth (feet) 125
- (3) static water level (feet) 70 below top of ground.
- (4) casing plastic 119 (material) (depth)
- (size) 4 1/2 If telescope see back.
- (5) screen 6' 119 (length) (depth to top)
- (size) 4 plastic (material)
- (6) pump (HP) (yield gpm)
- (type power)
- (7) electric log No (yes or no)
- (organization running log)
- (8) how well bottom plugged word peg

description of formations encountered

from

to

Red clay Iron Soil 0 18
Red sand 18 85
SD mt gravel 85 126


CODED



DRILLERS REMARKS:

If well telescopes please sketch and show depths.

GROUND LEVEL

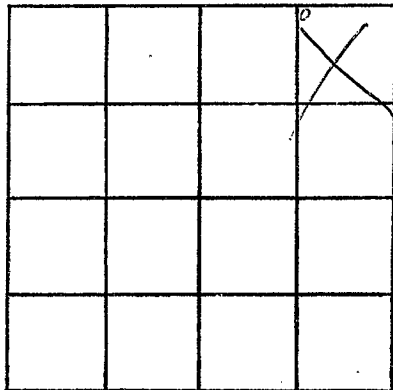

SECTION *[Handwritten Signature]*

Please indicate well location X.

ADDITIONAL INFORMATION

If more than one screen, show locations of each on sketch.