

Pike  
 D63  
 10-67

MISSISSIPPI  
 BOARD OF WATER COMMISSIONERS  
 416 North State Street  
 Jackson, Mississippi 39201

WATER WELL DRILLERS LOG

Oct 19 67 date well completed  
 Reeves well Drillers firm name  
 Pike county well located

LANDOWNER: Williams  
 Mr. Mullin  
 Fernwood  
 (mailing address)


WELL LOCATION:  
 sec 36 T 3 N R 7 E  
 1 miles west of Fernwood  
 (distance) (direction) (nearest town)

WELL PURPOSE: House  
 (home, irrigation, municipal, industrial)

- WELL COMPLETION DATA:
- (1) diameter (inches) 4"
  - (2) total depth (feet) 120
  - (3) static water level (feet) 105 below top of ground.
  - (4) casing Raster Galv (material) (depth)
  - (size) if telescope see back.
  - (5) screen 114' (length) (depth to top)  
 4" plastic (size) (material)
  - (6) pump 3/4 Sub 12 (HP) (yield gpm)  
 electric (type power)
  - (7) electric log NO (yes or no)  
 (organization running log)
  - (8) how well bottom plugged  
 washed plug

description of formations encountered	from	to
Red clay	0	18
Red cherty sand	18	90
gravel & sand	90	100
Red chert	100	108
gravel & sand	108	120


CODED

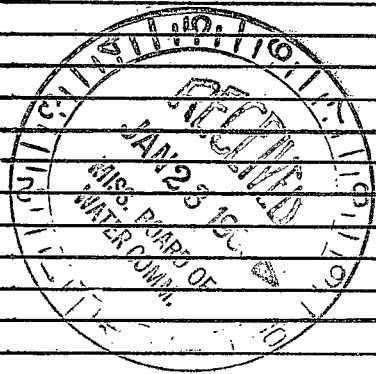

DRILLERS REMARKS:  
 New house

If well telescopes please sketch and show depths.

GROUND LEVEL

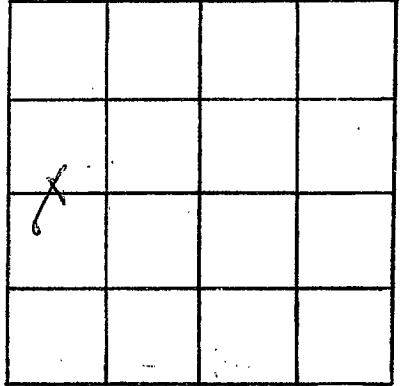

SECTION 36

Please indicate well location X.

ADDITIONAL INFORMATION

If more than one screen,  
show locations of each on sketch.