

MISSISSIPPI
BOARD OF WATER COMMISSIONERS
416 North State Street
Jackson, Mississippi 39201

WATER WELL DRILLERS LOG

Pike CODED
D64
1-68 CODED

Jan 25 1968 date well completed
J. Keenwell & Co. firm name
Pike county well located

LANDOWNER: J. James
RFD 3
McLamb
(mailing address)

description of formations encountered	from	to
top clay	0	12
Red chalk	12	41
bed sand and gravel	41	95
Small gravel sand	95	112

WELL LOCATION:
sec. 22 T. 3 N R. 7 E
2 miles SW of McLamb
(distance) (direction) (nearest town)

WELL PURPOSE: home
(home, irrigation, municipal, industrial)

WELL COMPLETION DATA:


- (1) diameter (inches) 4"
- (2) total depth (feet) 112
- (3) static water level (feet) 98 below above top of ground.
- (4) casing Plastic bottom (material) (depth)
- (size) if telescope see back.
- (5) screen 6' 106 (length) (depth to top)
4" Plastic (size) (material)
- (6) pump 1/2 sub 19 (HP) (yield gpm)
Electric (type power)
- (7) electric log NO. (yes or no)

CODED

(organization running log)


(8) how well bottom plugged
wooden plug

DRILLERS REMARKS:
Inspecting old Red Pump

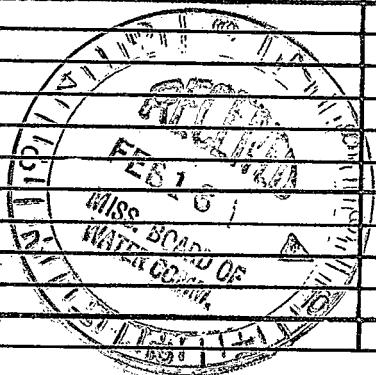

If well telescopes please sketch and show depths.

GROUND LEVEL

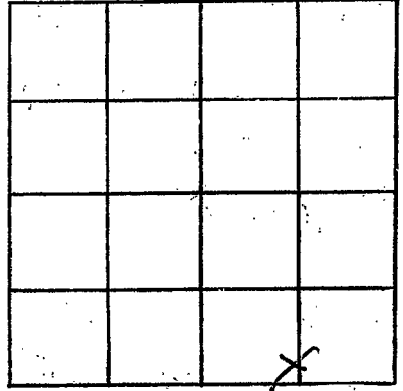

SECTION 22

Please indicate well location X.

ADDITIONAL INFORMATION

If more than one screen, show locations of each on sketch.