

PIKE

MISSISSIPPI BOARD OF WATER COMMISSIONERS

D68 CODED

5-9-61 CODED

WATER WELL DRILLERS LOG

CODED

Date: 5-9, 1961, Driller: Chester Reeves County Pike
(Name)

(1) Owner of Land: D.C. Spurl
(Name)
McCamb
(Address)

(2) Location: 32-3-7
1/4, 1/4, Sec. T R
Perry Quin Park
(distance) (direction) (Nearest Town)

(3) Topography: Hilly
(Hilly) (Flat) (Level)

(4) Purpose of Well: Domestic
(Domestic Irrigation
Municipal, Industrial, Other)

Description & Color of Materials Sand, Clay, Red Clay, Shell, etc.	Thick- ness Feet	Depth Feet
<u>Red Clay</u>	<u>10</u>	<u>10</u>
<u>Red sand & gravel</u>	<u>20</u>	<u>30</u>
<u>Red gravel & sand</u>	<u>7</u>	<u>37</u>

Information upon completion of well:

(1) Diameter: 4" inches. Plastics

(2) Total Depth: 39 feet.

(3) Water Level: 25 feet below top of ground.

(4) Cased to: Bottom Size 4"

(5) Screen: Size 1/2" Length _____


(6) Were any formations sealed against pollution?
_____ yes, _____ no.

If YES depth of formation _____

Why _____

Drillers Remarks: New house
no previous
well

CODED

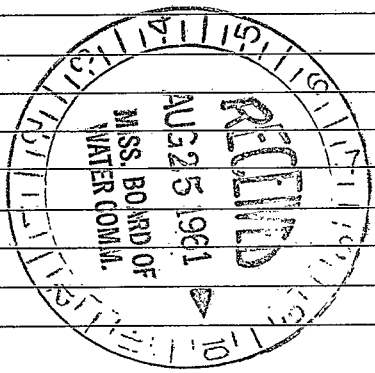

(Use Back Side)

Well No.

